


1000 Jorie Blvd.

1000 Jorie Blvd.
Oak Brook, IL, 60523

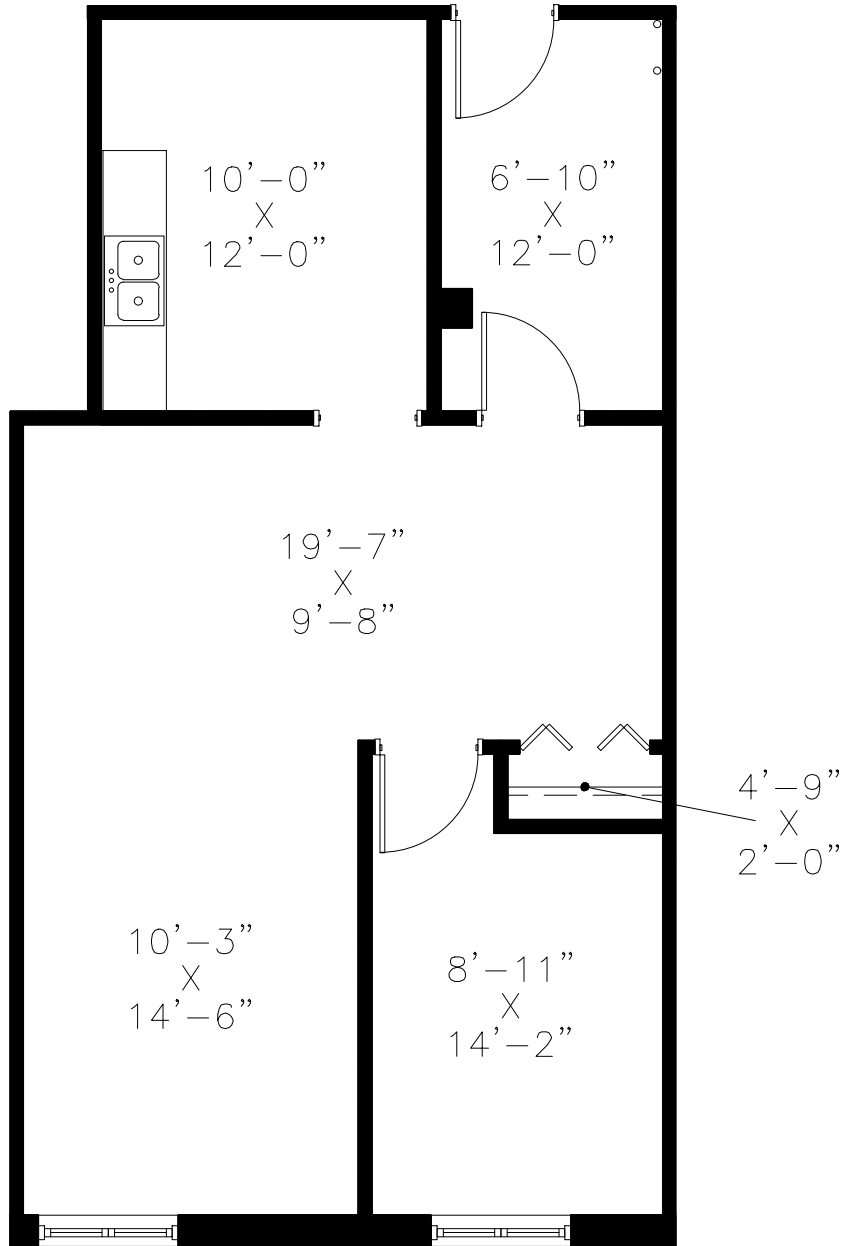

Suite #240 - As-Built Conditions

807 Rentable Square Feet

Scale:

N.T.S.