


# 1000 Jorie Blvd.

1000 Jorie Blvd.  
Oak Brook, IL, 60523

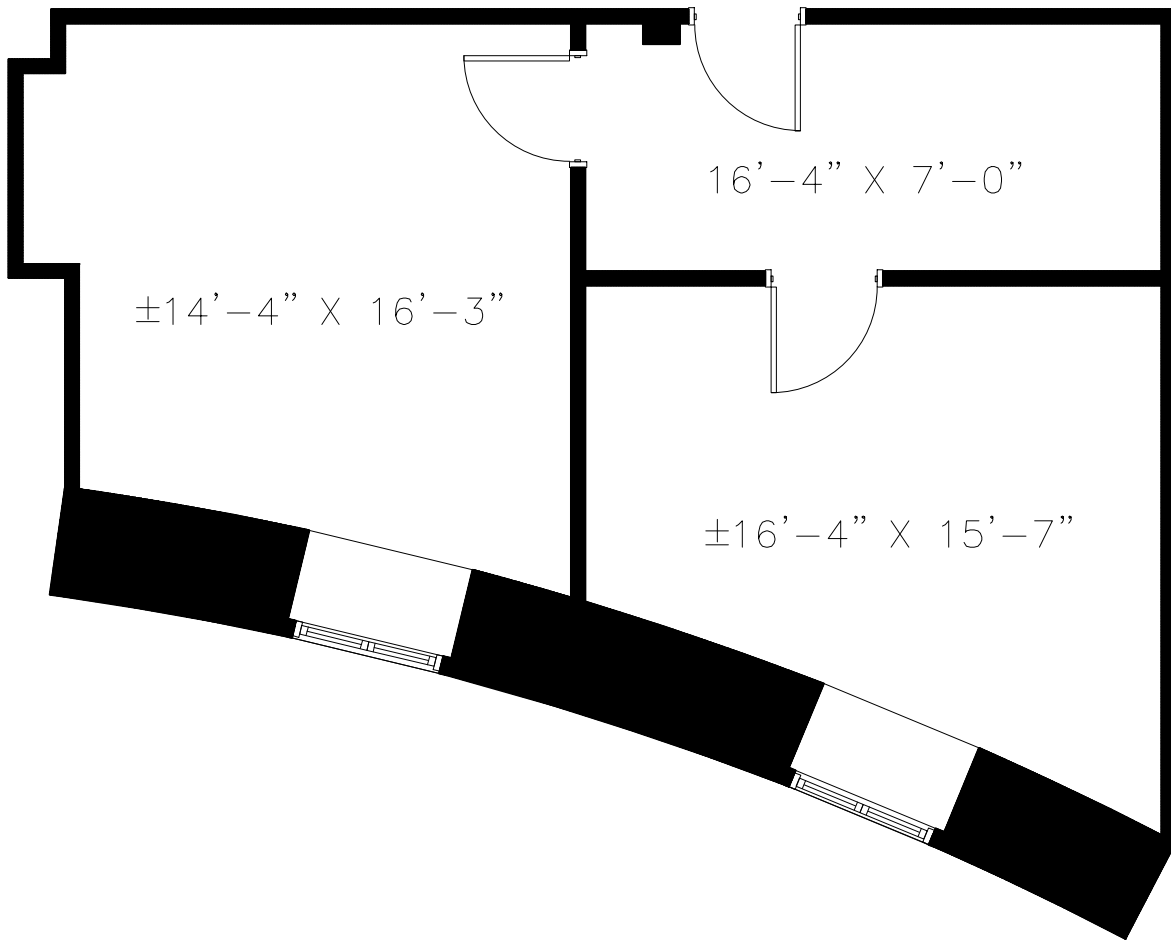

## Suite #364 - As-Built Conditions

651 Rentable Square Feet

Scale:

N.T.S.