


1010 Jorie Blvd.

1010 Jorie Blvd.
Oak Brook, IL, 60523

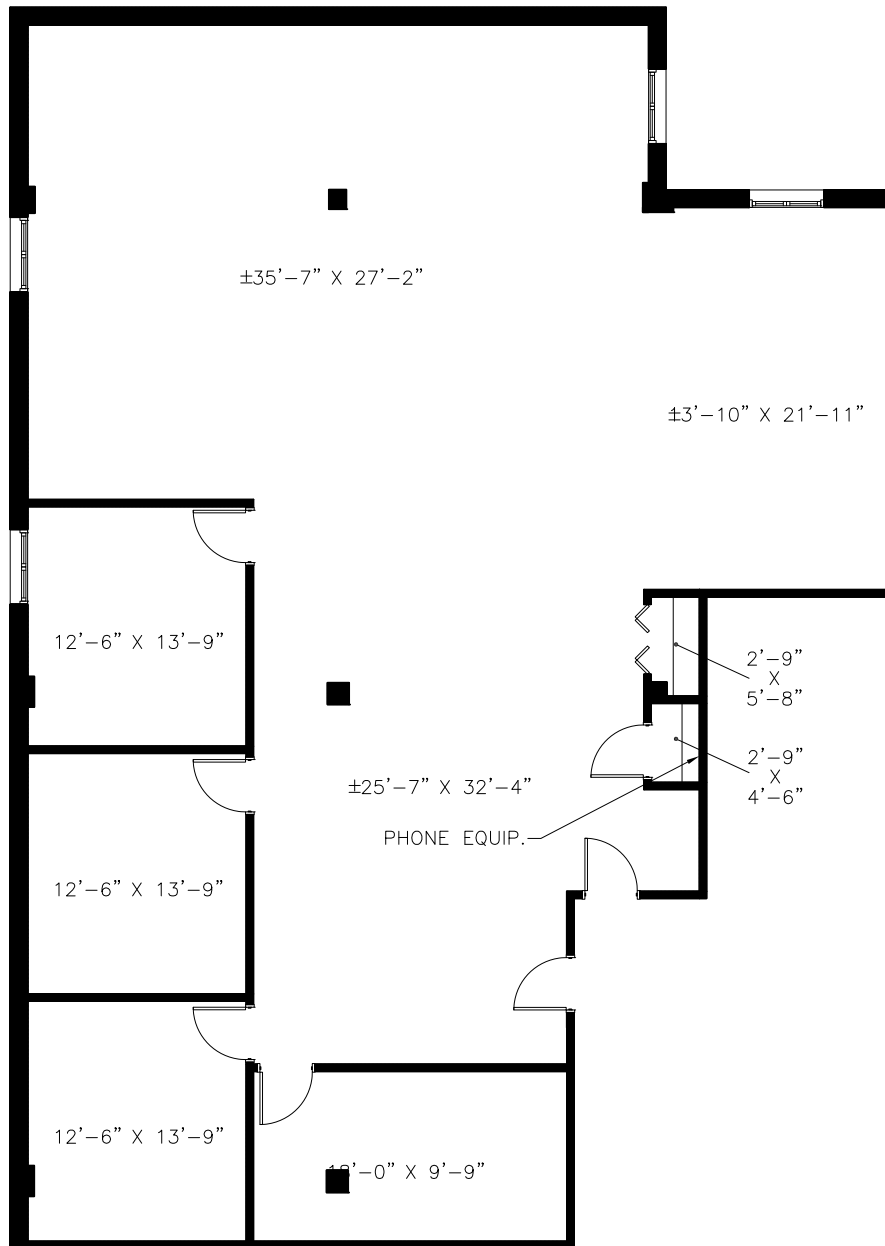

Suite #24 - As-Built Conditions

3,135 Rentable Square Feet

Scale:

N.T.S.