


# 1010 Jorie Blvd.

1010 Jorie Blvd.  
Oak Brook, IL, 60523

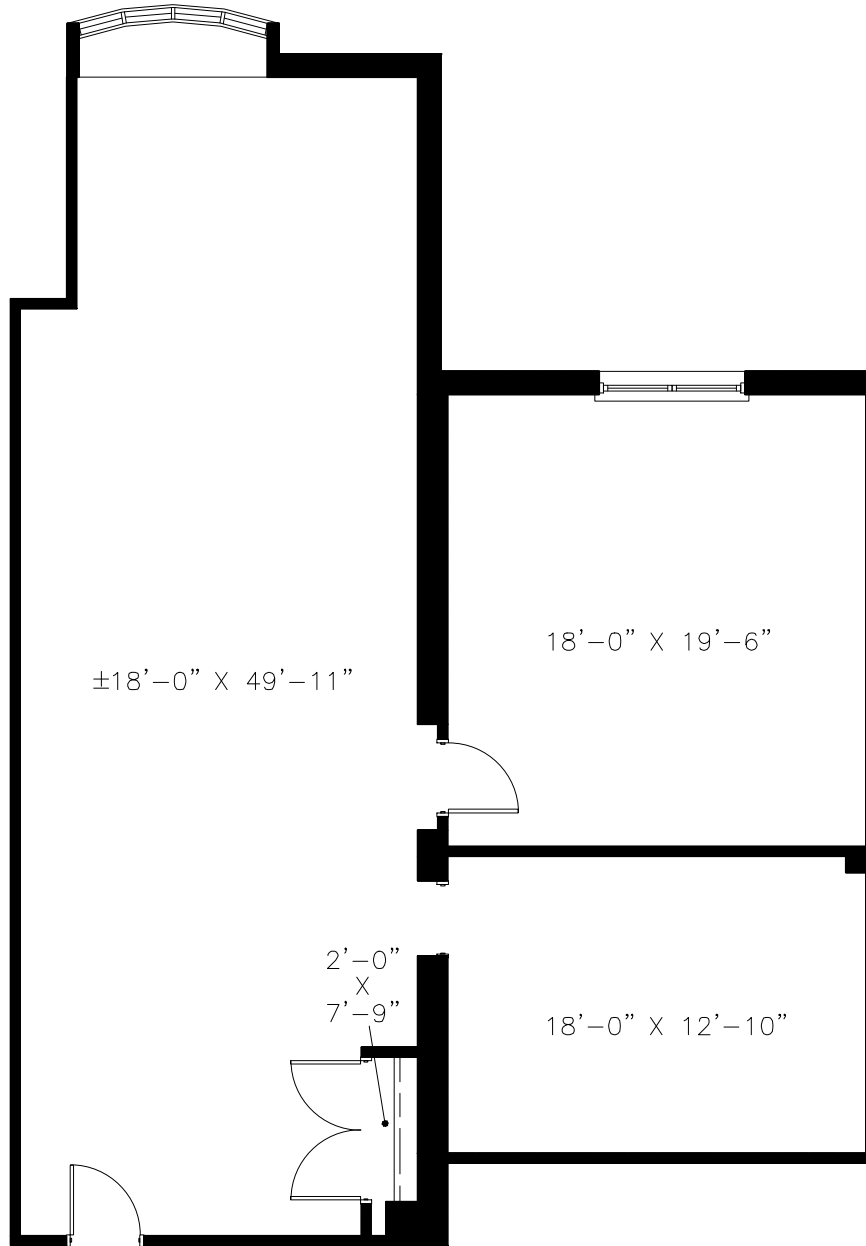

## Suite #240 - As-Built Conditions

1,710 Rentable Square Feet

Scale:

N.T.S.