


120 East Ogden Avenue

120 East Ogden Avenue
Hinsdale, IL, 60521

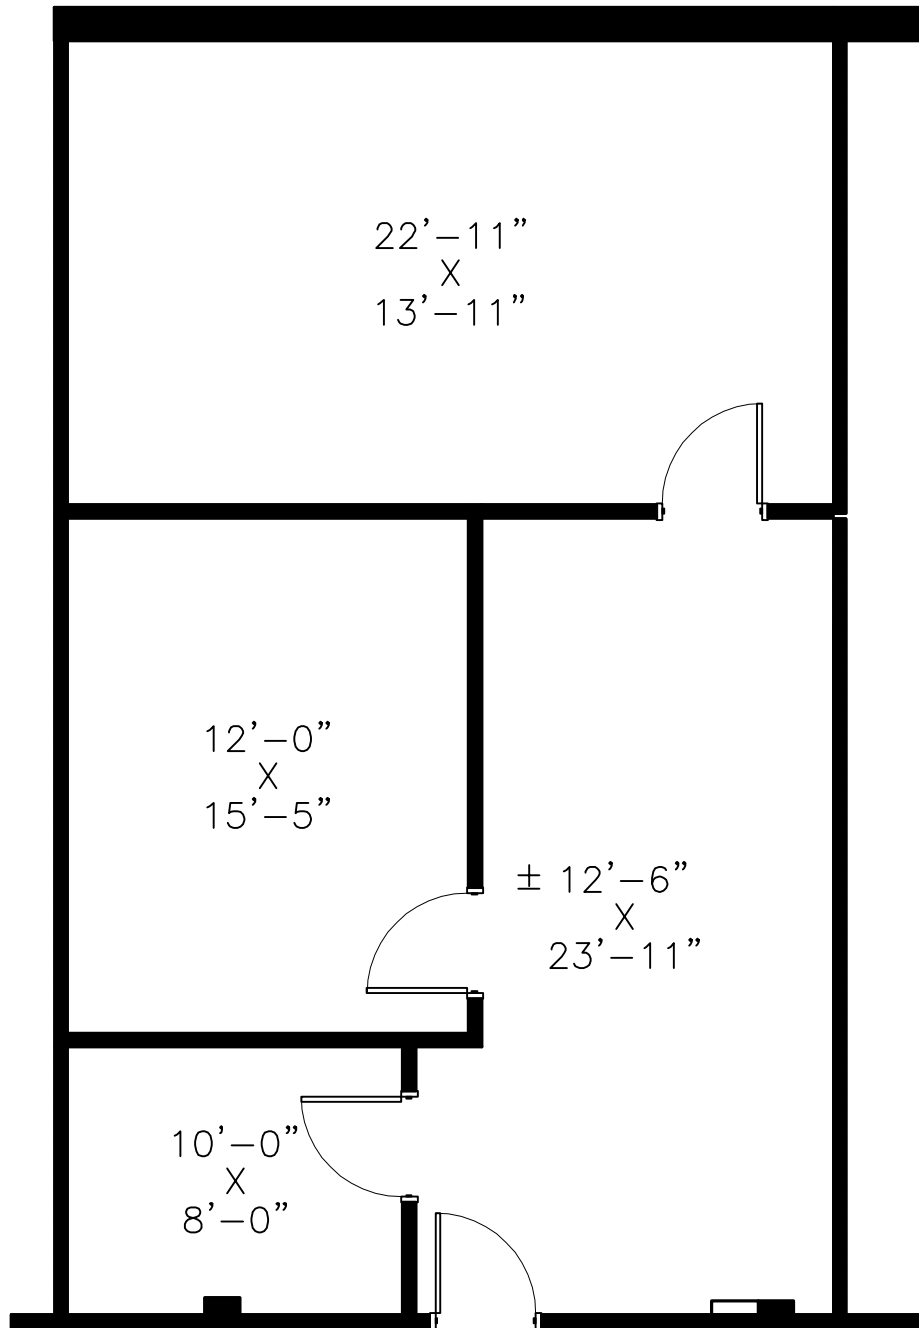

Suite #18 - As-Built Conditions

1,018 Rentable Square Feet

Scale:

N.T.S.