


# 120 East Ogden Avenue

120 East Ogden Avenue  
Hinsdale, IL, 60521

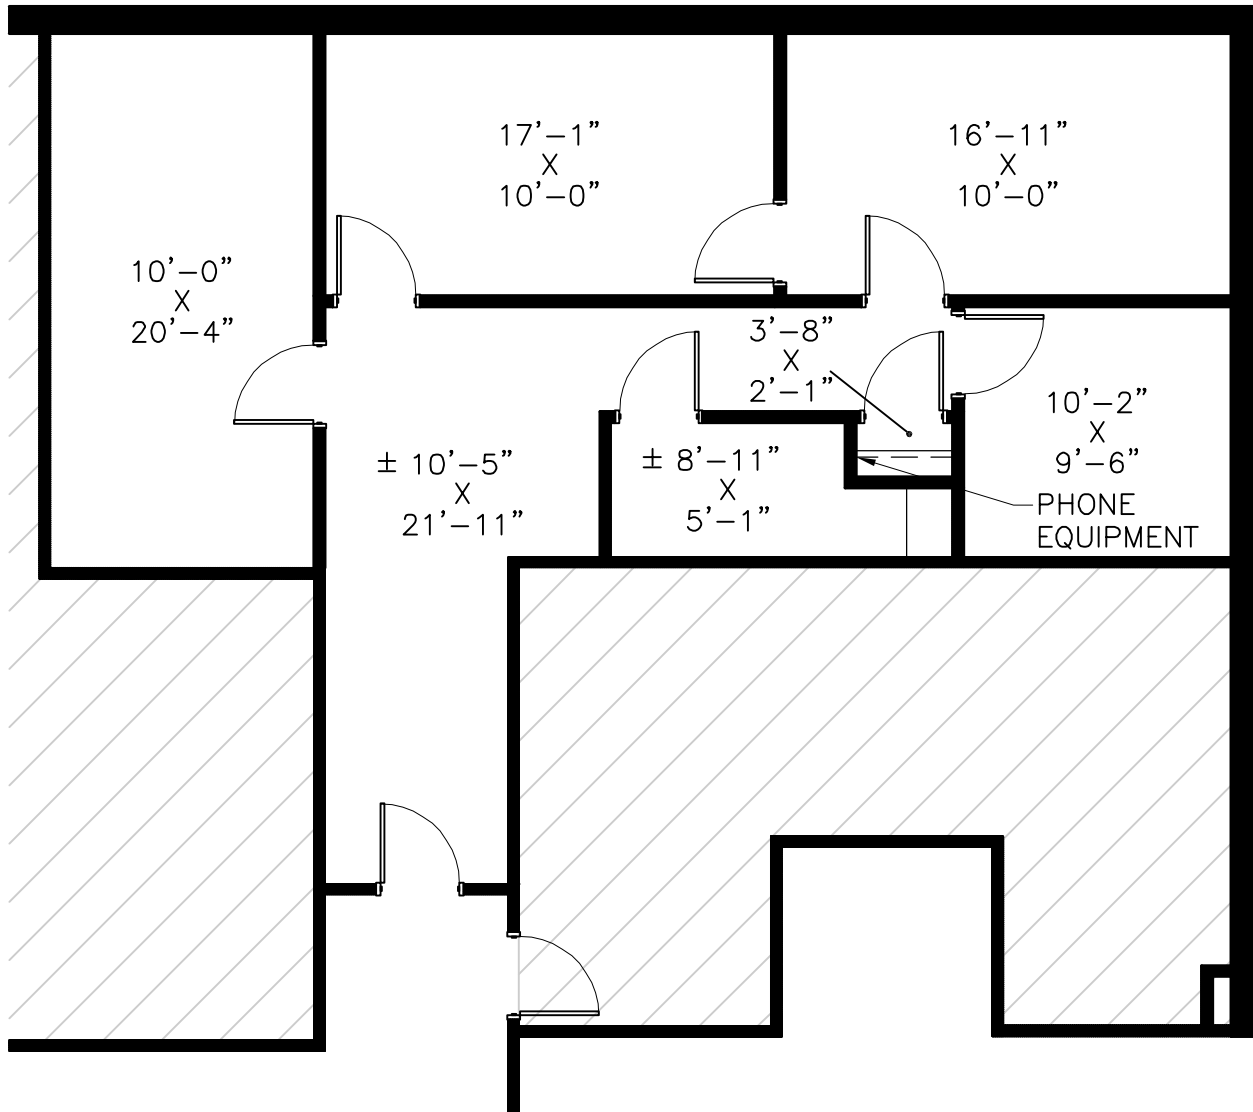

## Suite #22 - As-Built Conditions

1,138 Rentable Square Feet

Scale:

N.T.S.