


15 Spinning Wheel Road

15 Spinning Wheel Road
Hinsdale, IL, 60521

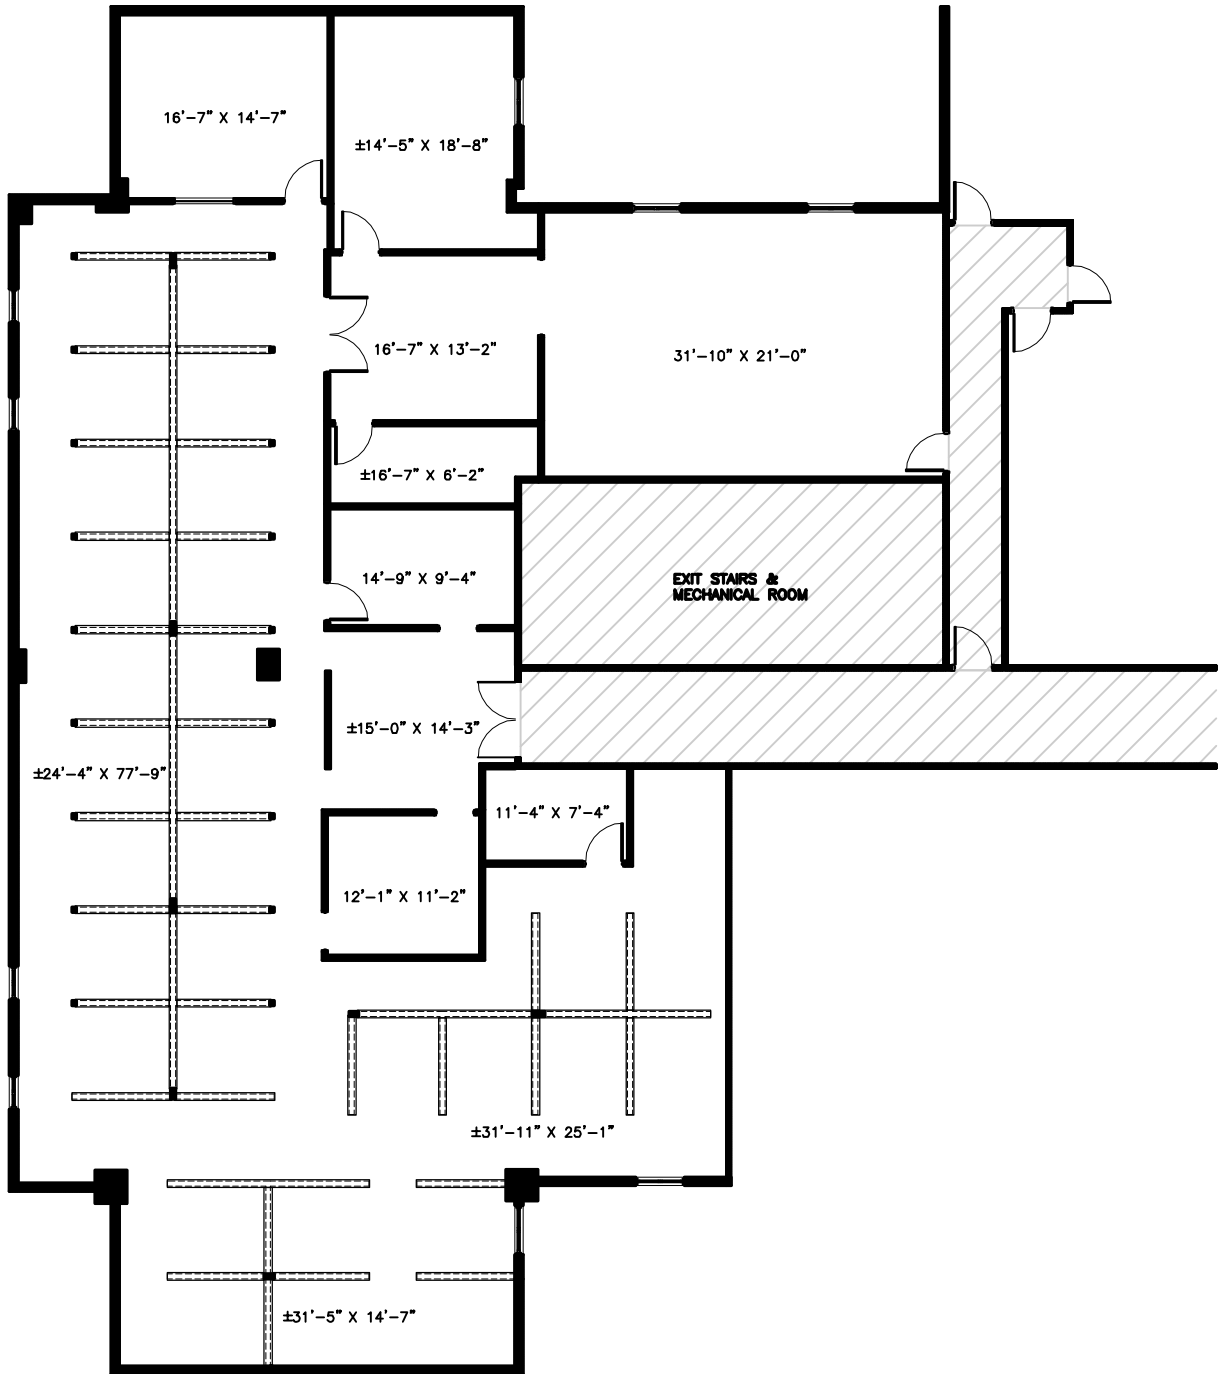

Suite 16 - As-Built Conditions

6,013 Rentable Square Feet

Scale:

N.T.S.