


# 15 Spinning Wheel Road

15 Spinning Wheel Road  
Hinsdale, IL, 60521

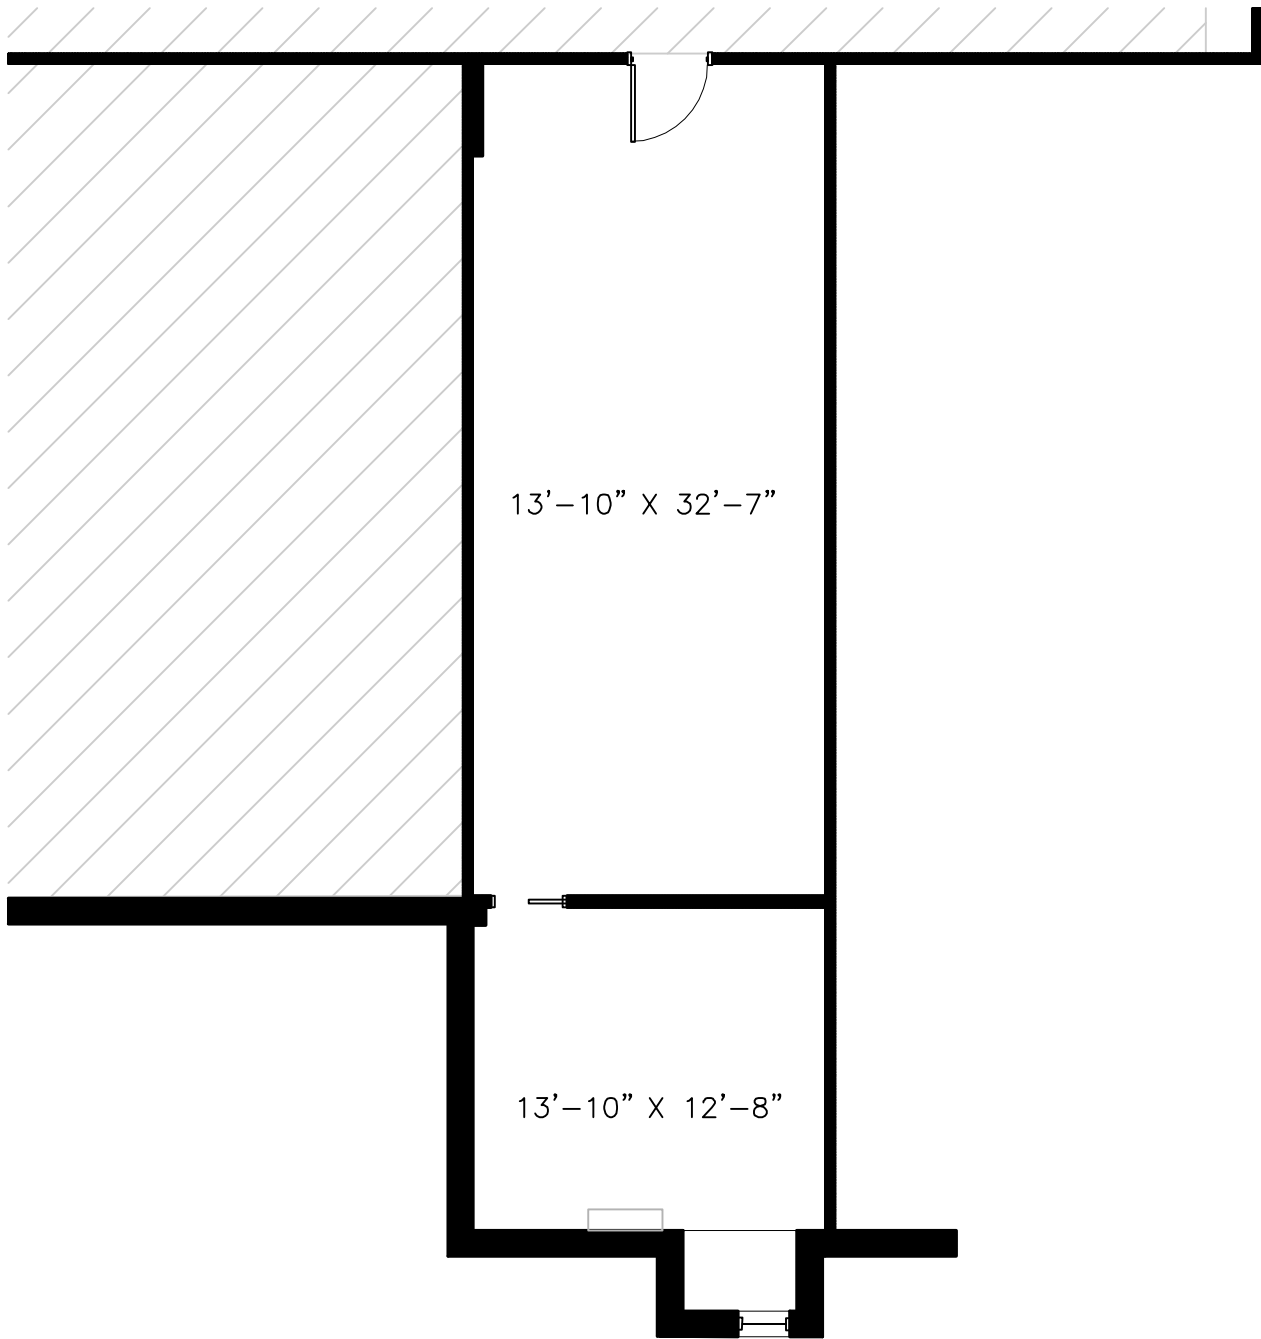

## Suite 400 - As-Built Conditions

754 Rentable Square Feet

Scale:

N.T.S.