


15 Spinning Wheel Road

15 Spinning Wheel Road
Hinsdale, IL, 60521

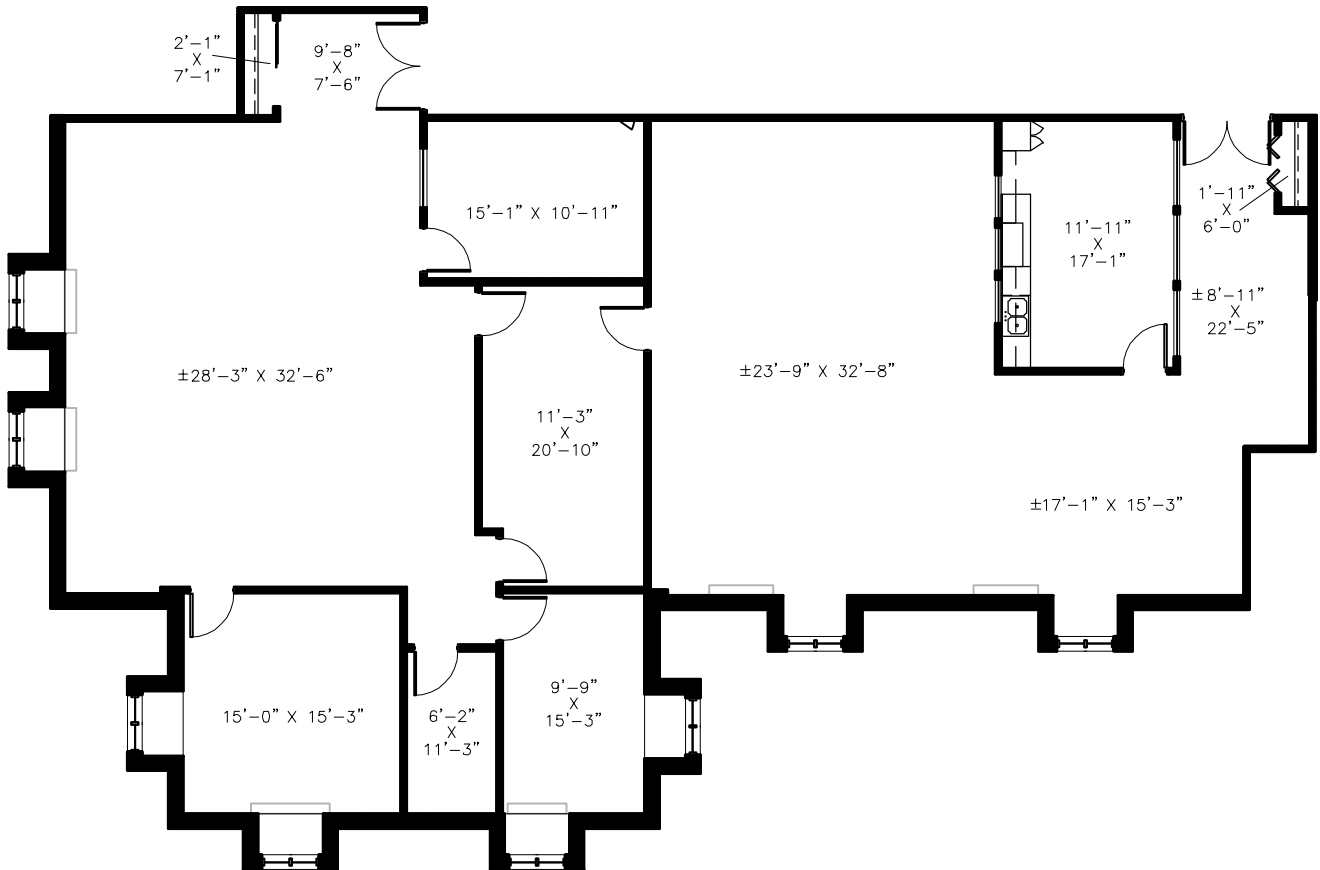

Suite 410 - As-Built Conditions

3,939 Rentable Square Feet

Scale:

N.T.S.