


# 188 Industrial Drive

188 Industrial Drive  
Elmhurst, Illinois 60126

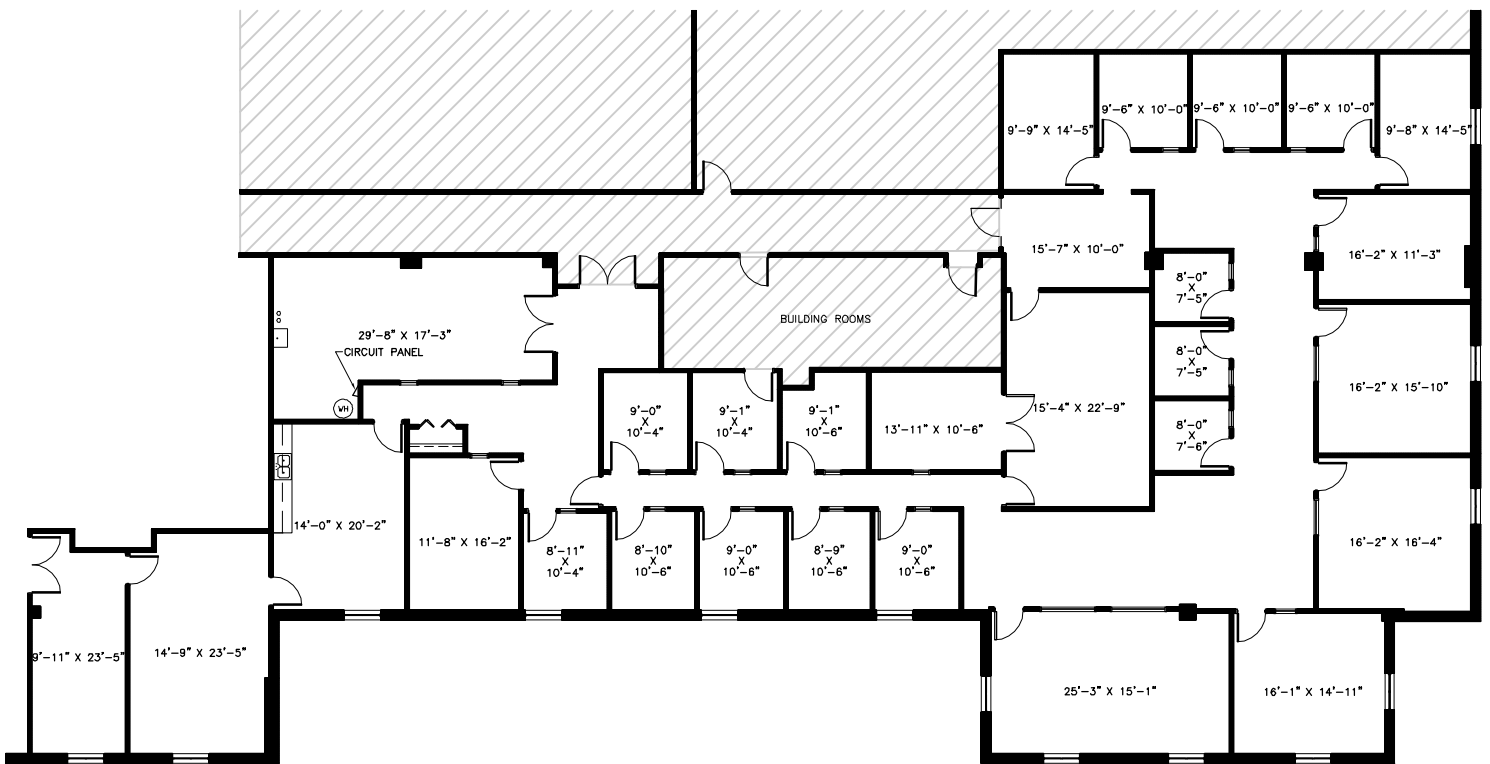

## Suite #315 - As-Built Conditions

7,528 Rentable Square Feet

Scale:

N.T.S.