


188 Industrial Drive

188 Industrial Drive
Elmhurst, Illinois 60126

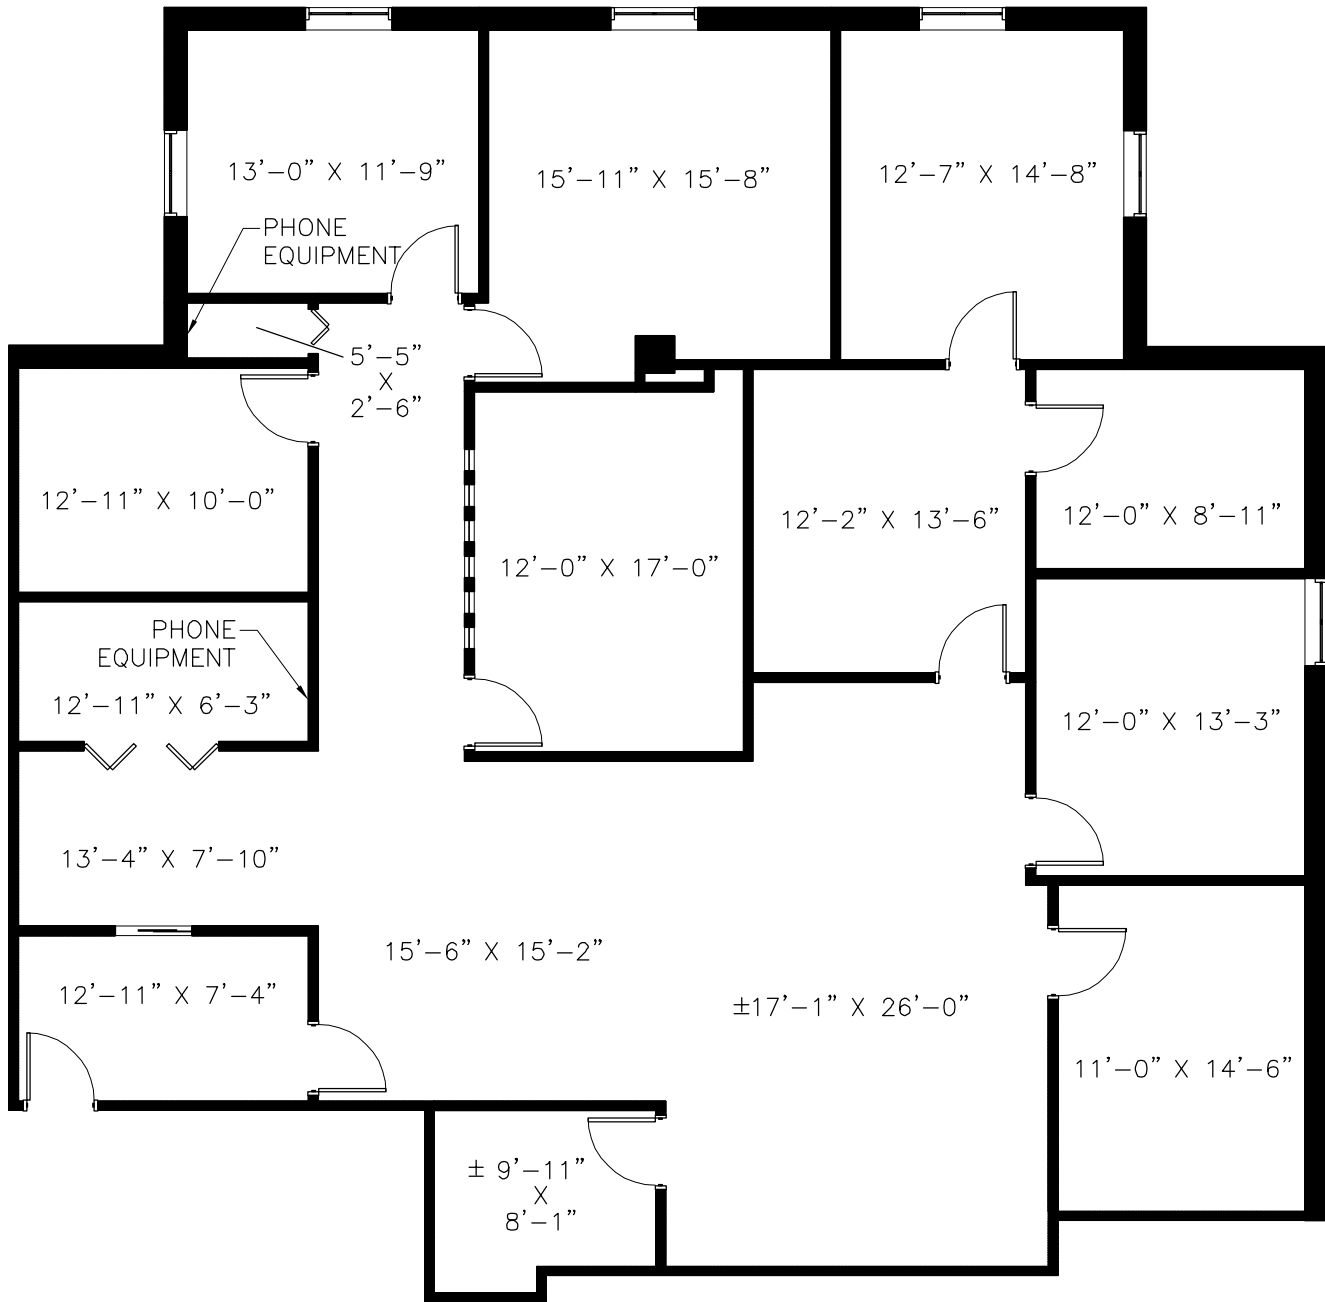

Suite #206 - As-Built Conditions

3,182 Rentable Square Feet

Scale:

N.T.S.