


201 East Ogden Avenue

201 East Ogden Avenue
Hinsdale, IL, 60521

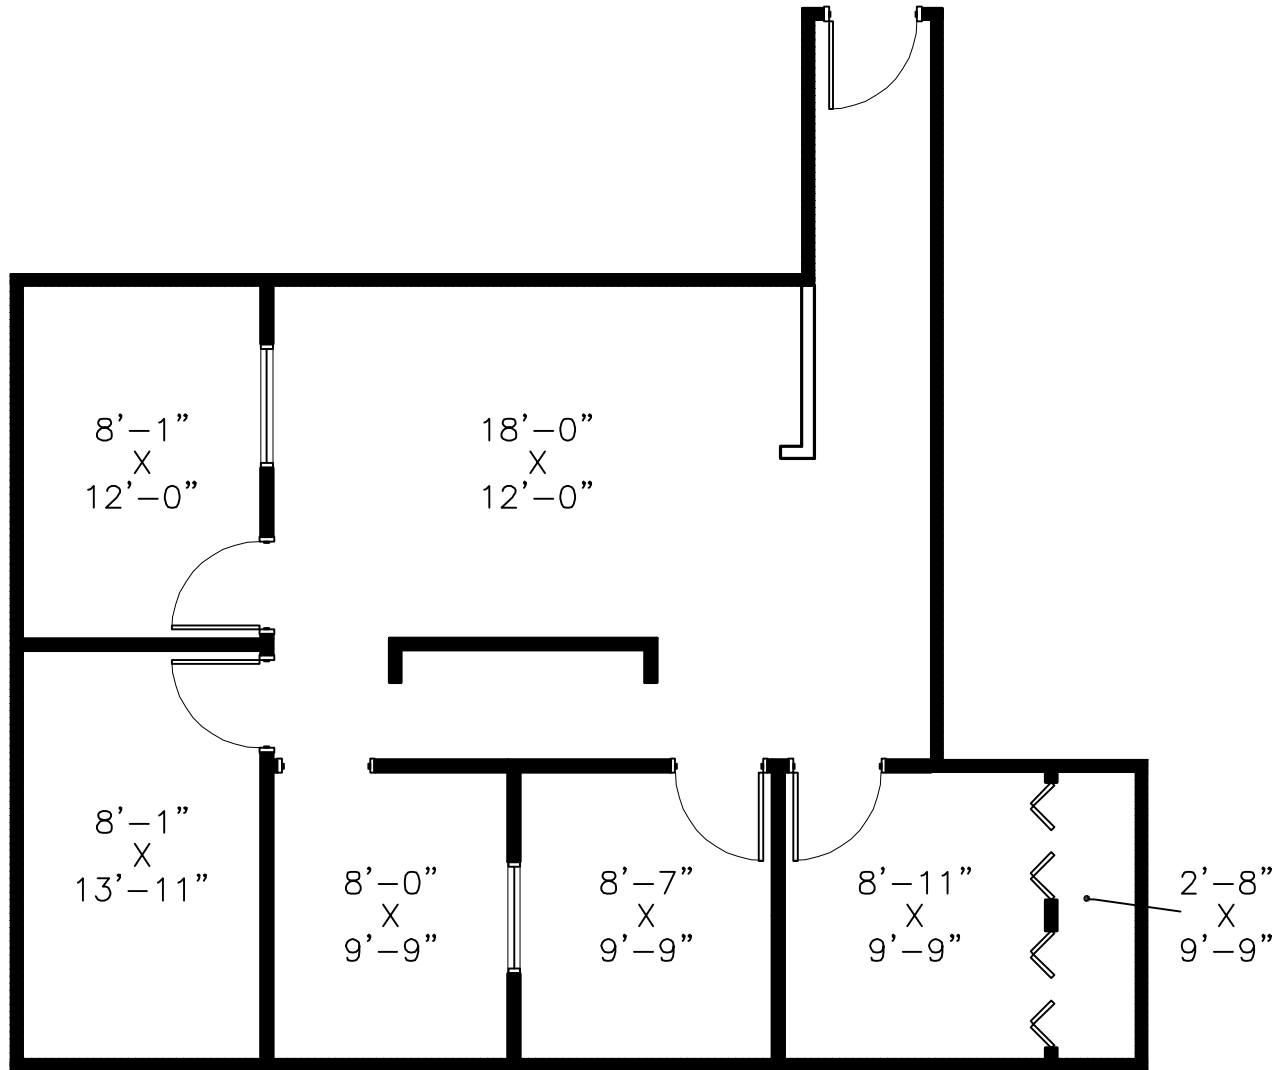

Suite 15 - As-Built Conditions

1,080 Rentable Square Feet

Scale:

N.T.S.