


# 201 East Ogden Avenue

201 East Ogden Avenue  
Hinsdale, IL, 60521

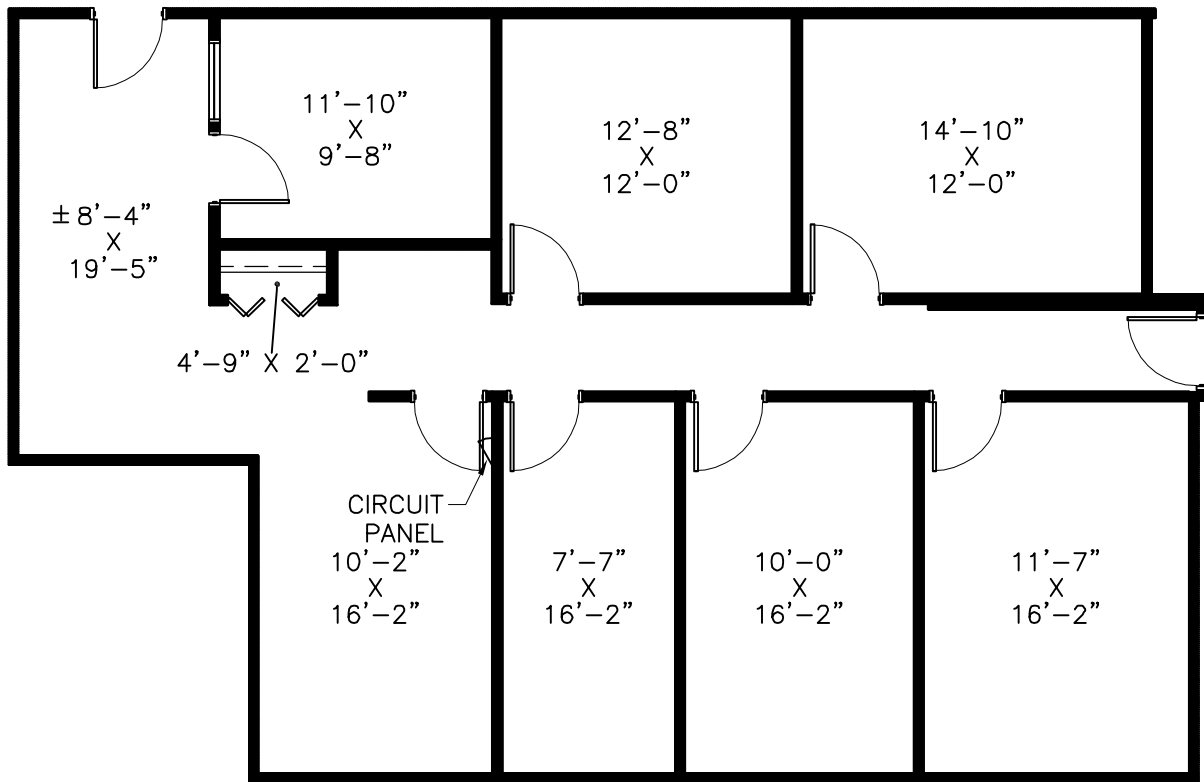

## Suites 40 & 44 - As-Built Conditions

1,744 Rentable Square Feet

Scale:

N.T.S.