


900 Jorie Boulevard

900 Jorie Boulevard
Oak Brook, Illinois 60523

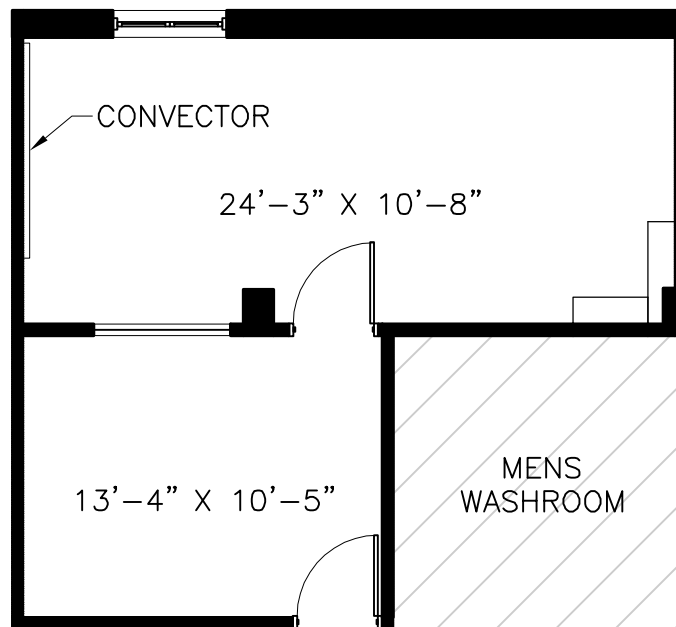

Suite #246 - As-Built Conditions

469 Rentable Square Feet

Scale:

N.T.S.