


900 Jorie Boulevard

900 Jorie Boulevard
Oak Brook, Illinois 60523

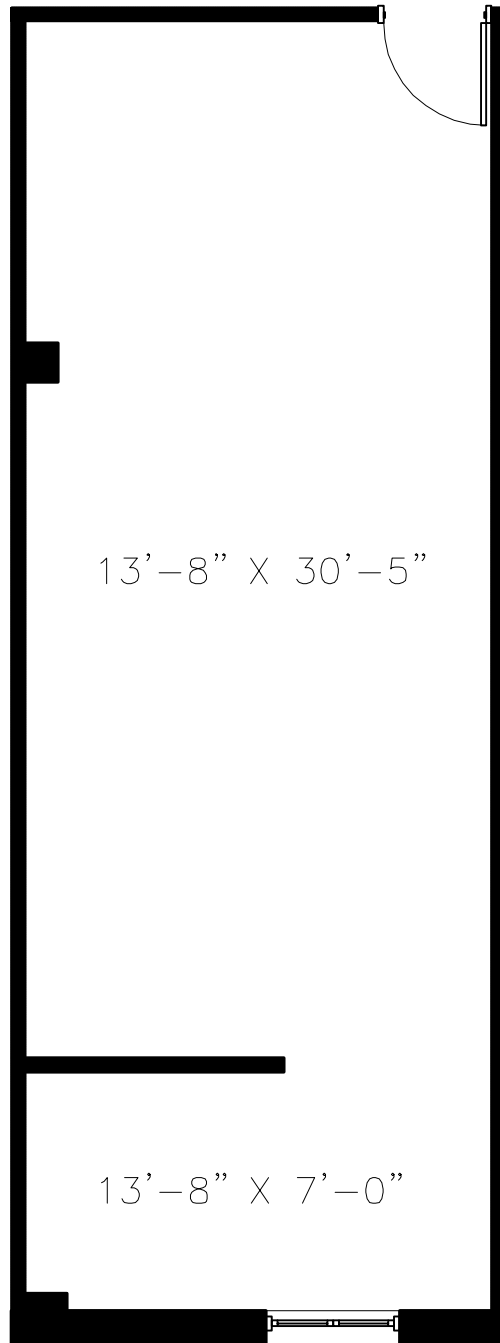

Suite #22 - As-Built Conditions

608 Rentable Square Feet

Scale:

N.T.S.