


# 900 Jorie Boulevard

900 Jorie Boulevard  
Oak Brook, Illinois 60523

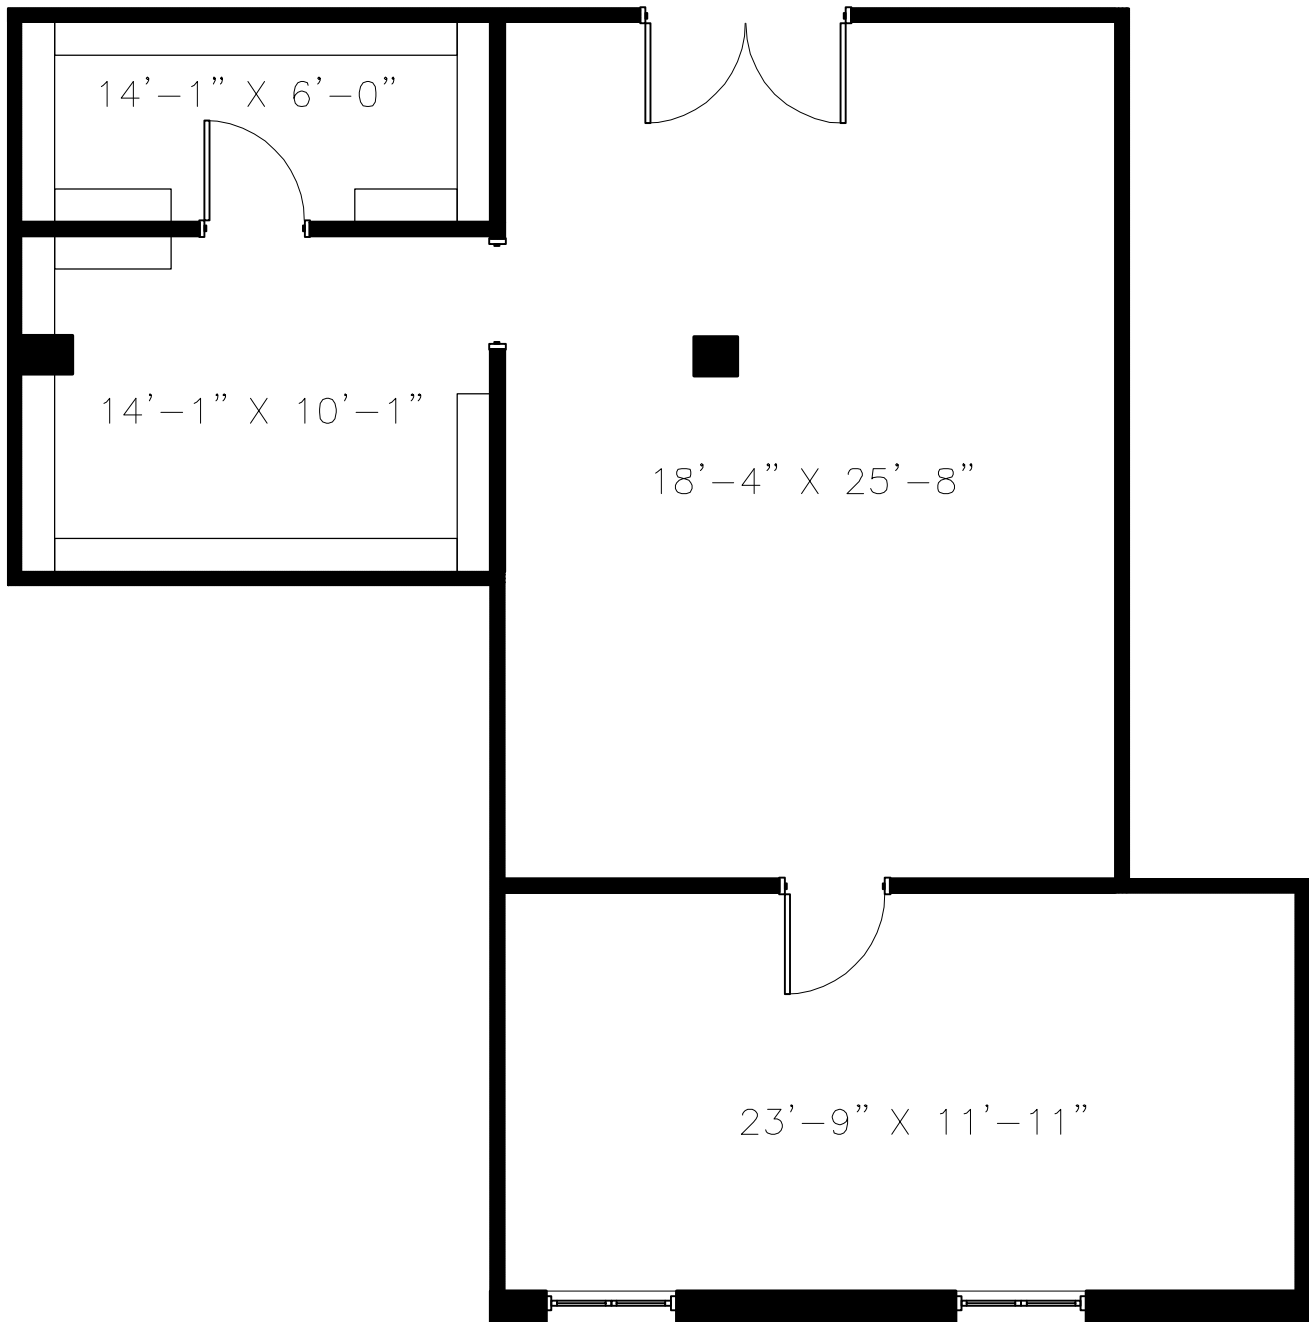

## Suite #85 - As-Built Conditions

1,167 Rentable Square Feet

Scale:

N.T.S.