


930 York Road

930 York Road
Hinsdale, IL, 60521

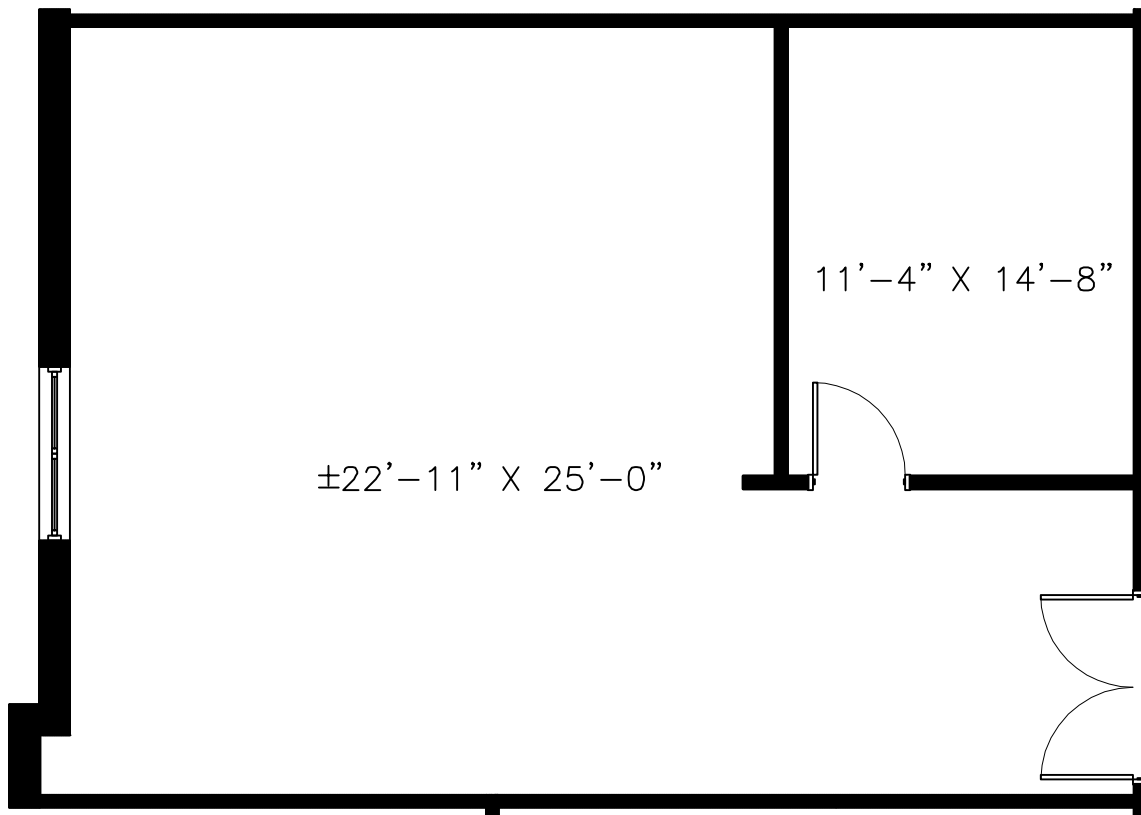

Suite #12 - As-Built Conditions

1,009 Rentable Square Feet

Scale:

1/8"=1'-0"