


# 930 York Road

930 York Road  
Hinsdale, IL, 60521

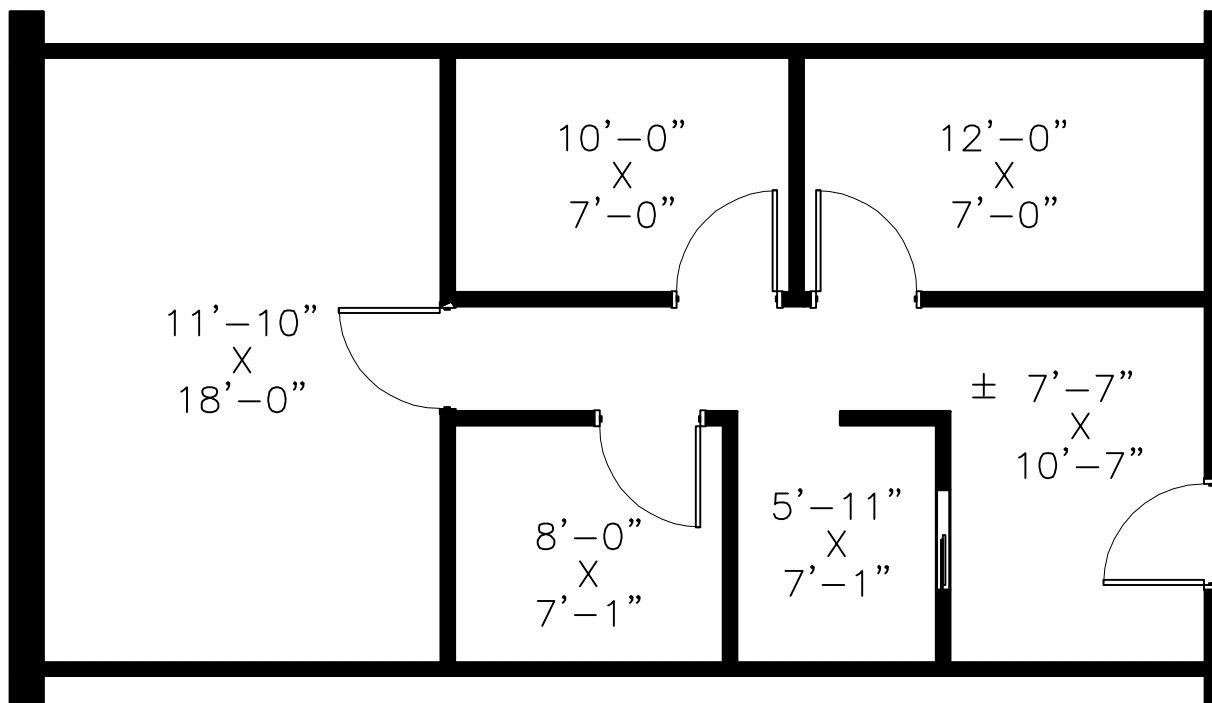

## Suite #14 - As-Built Conditions

727 Rentable Square Feet

Scale:

N.T.S.