


1000 Jorie Blvd.

1000 Jorie Blvd.
Oak Brook, IL, 60523

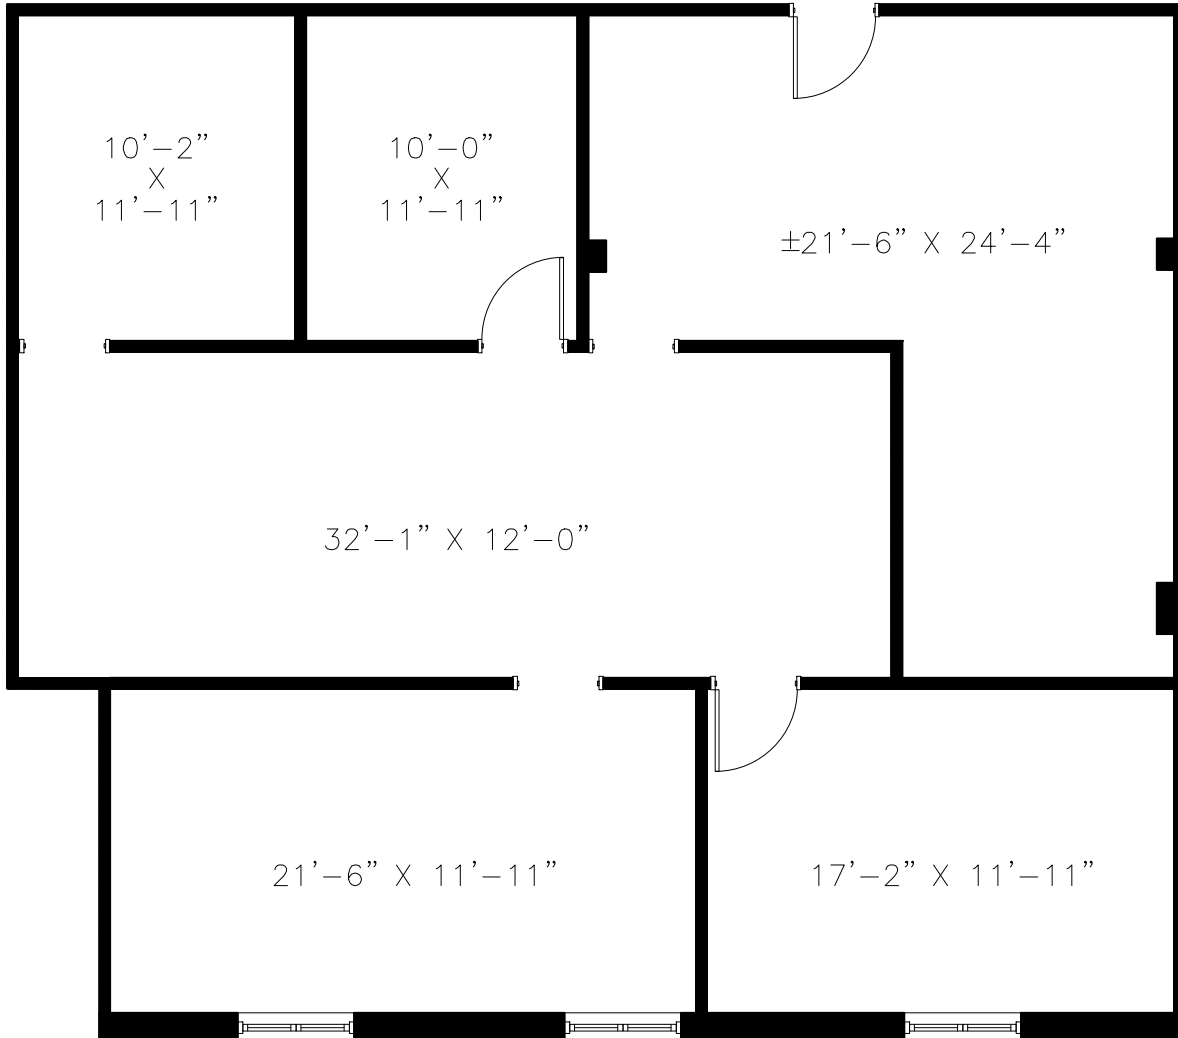

Suite #208 - As-Built Conditions

1,752 Rentable Square Feet

Scale:

N.T.S.