


# 1000 Jorie Blvd.

1000 Jorie Blvd.  
Oak Brook, IL, 60523

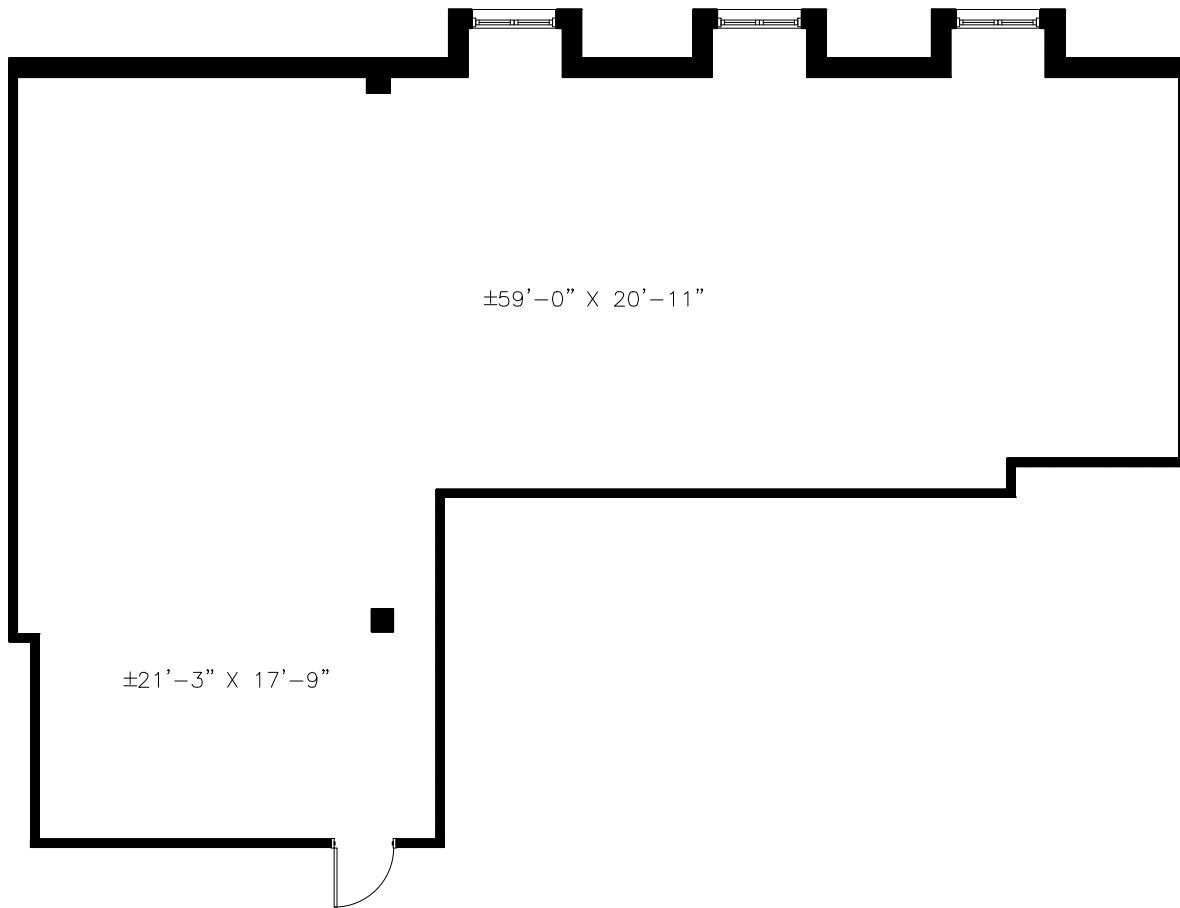

## Suite #345 - As-Built Conditions

1,881 Rentable Square Feet

Scale:

N.T.S.