


119 East Ogden Avenue

119 East Ogden Avenue
Hinsdale, IL, 60521

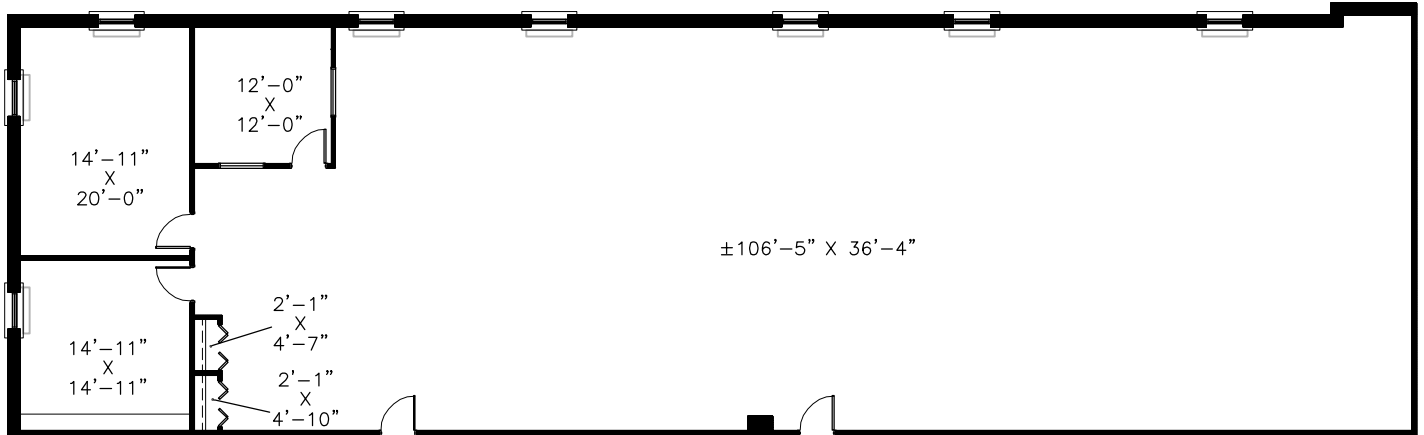

Suite 201 - As-Built Conditions

4,916 Rentable Square Feet

Scale:

N.T.S.