


119 East Ogden Avenue

119 East Ogden Avenue
Hinsdale, IL, 60521

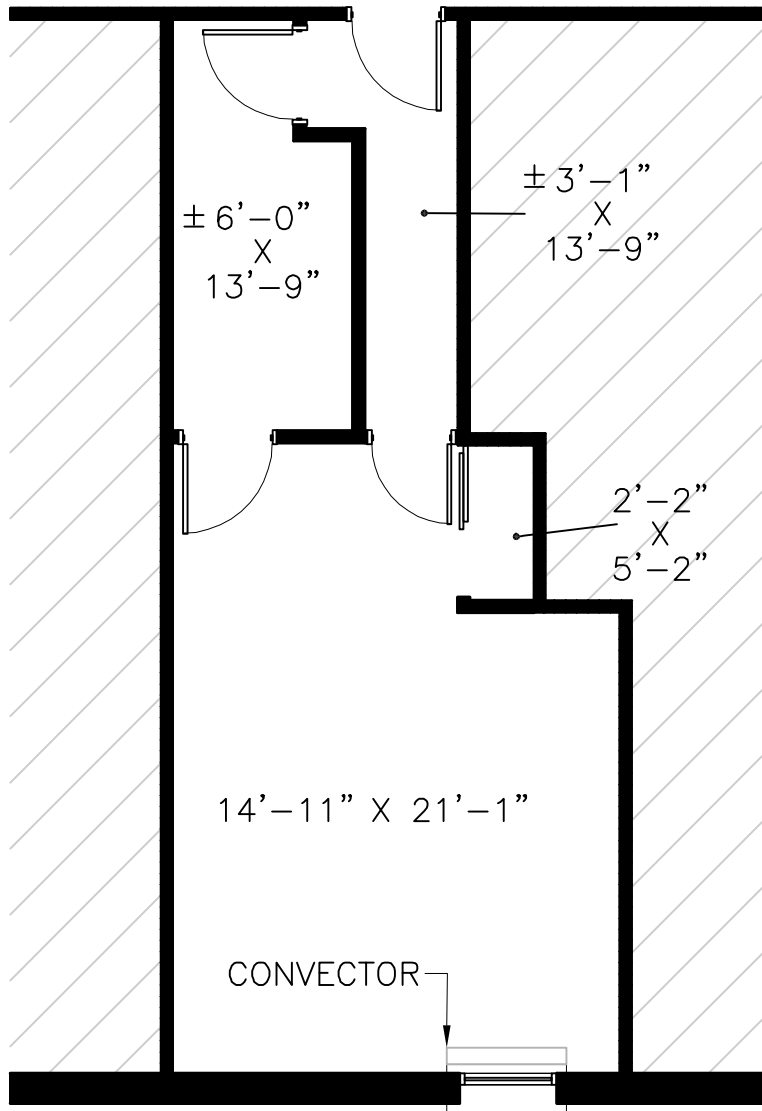

Suite #214 - As-Built Conditions

513 Rentable Square Feet

Scale:

N.T.S.