
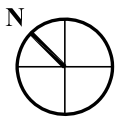


# 119 East Ogden Avenue

Hinsdale, IL 60521

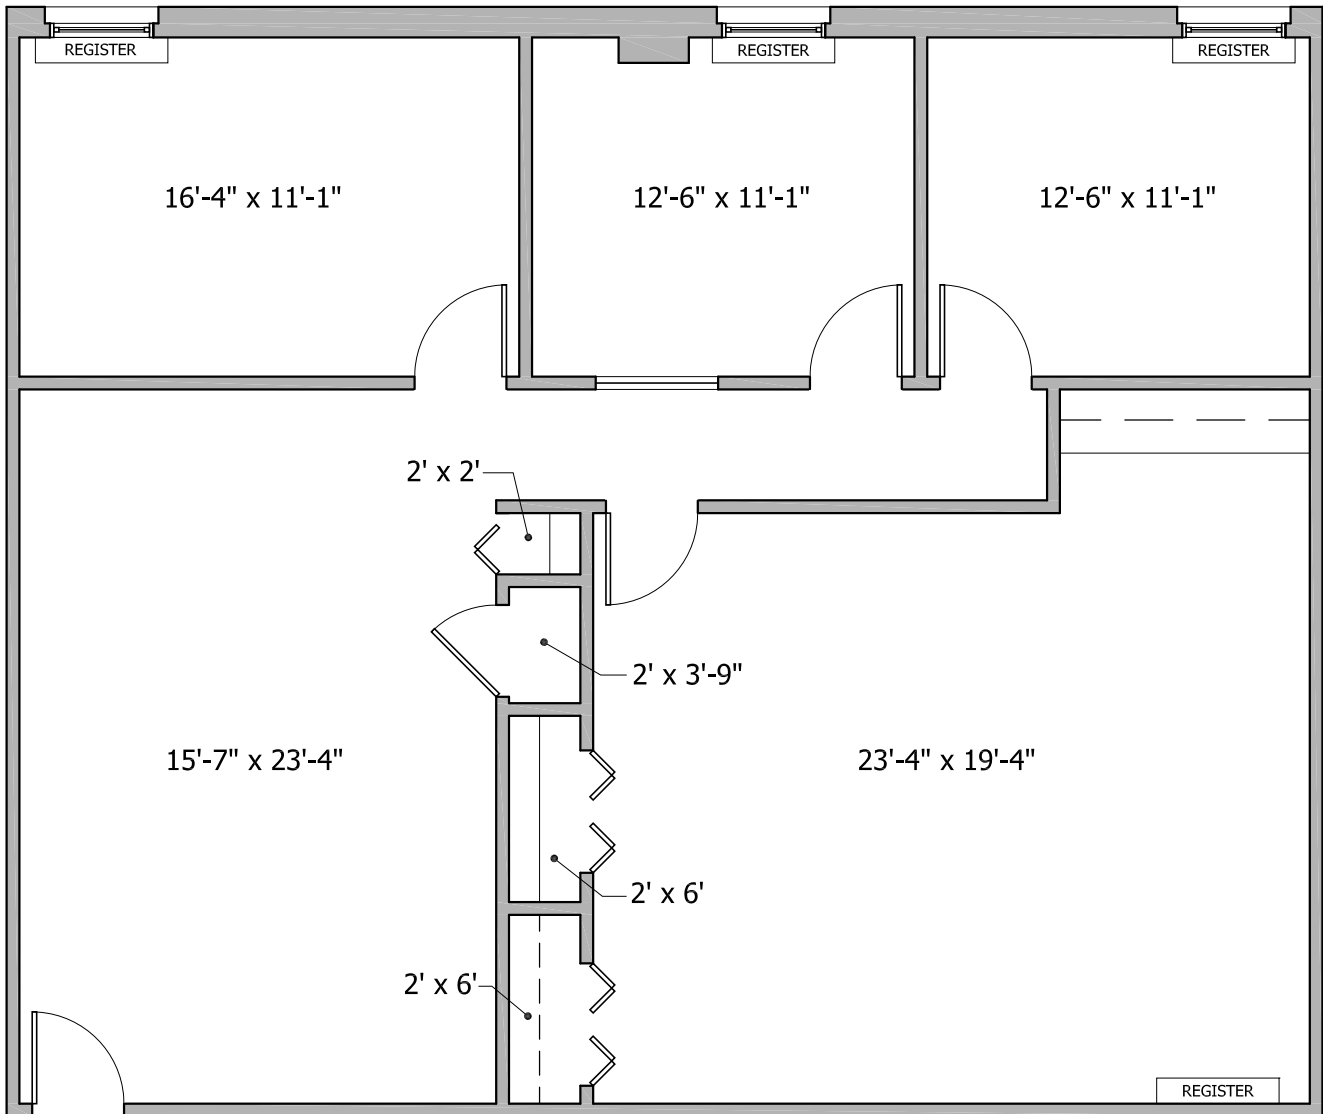

## Suite 120 - As-Built Condition

1,691 Rentable Square Feet

Scale: N.T.S.