


120 East Ogden Avenue

120 East Ogden Avenue
Hinsdale, IL, 60521

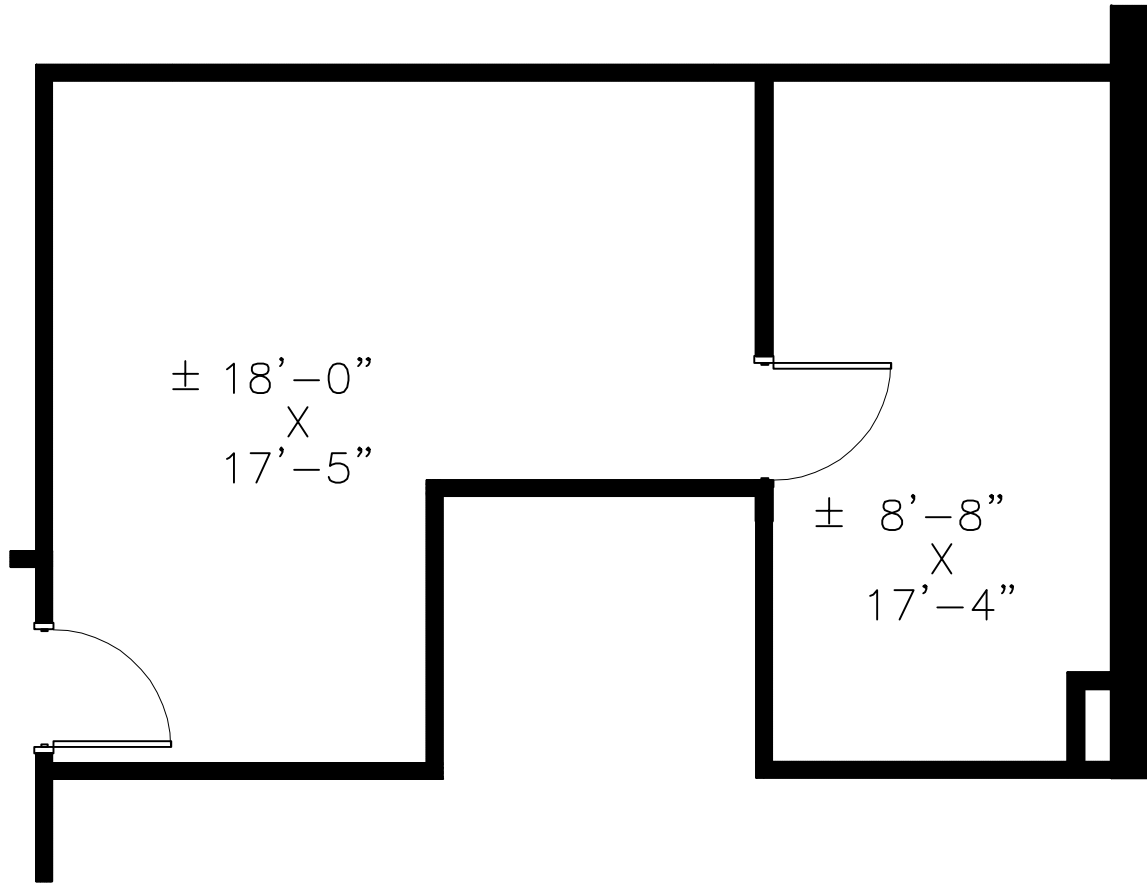

Suite #19 - As-Built Conditions

482 Rentable Square Feet

Scale:

N.T.S.