


15 Spinning Wheel

15 Spinning Wheel Road
Hinsdale, Illinois 60521

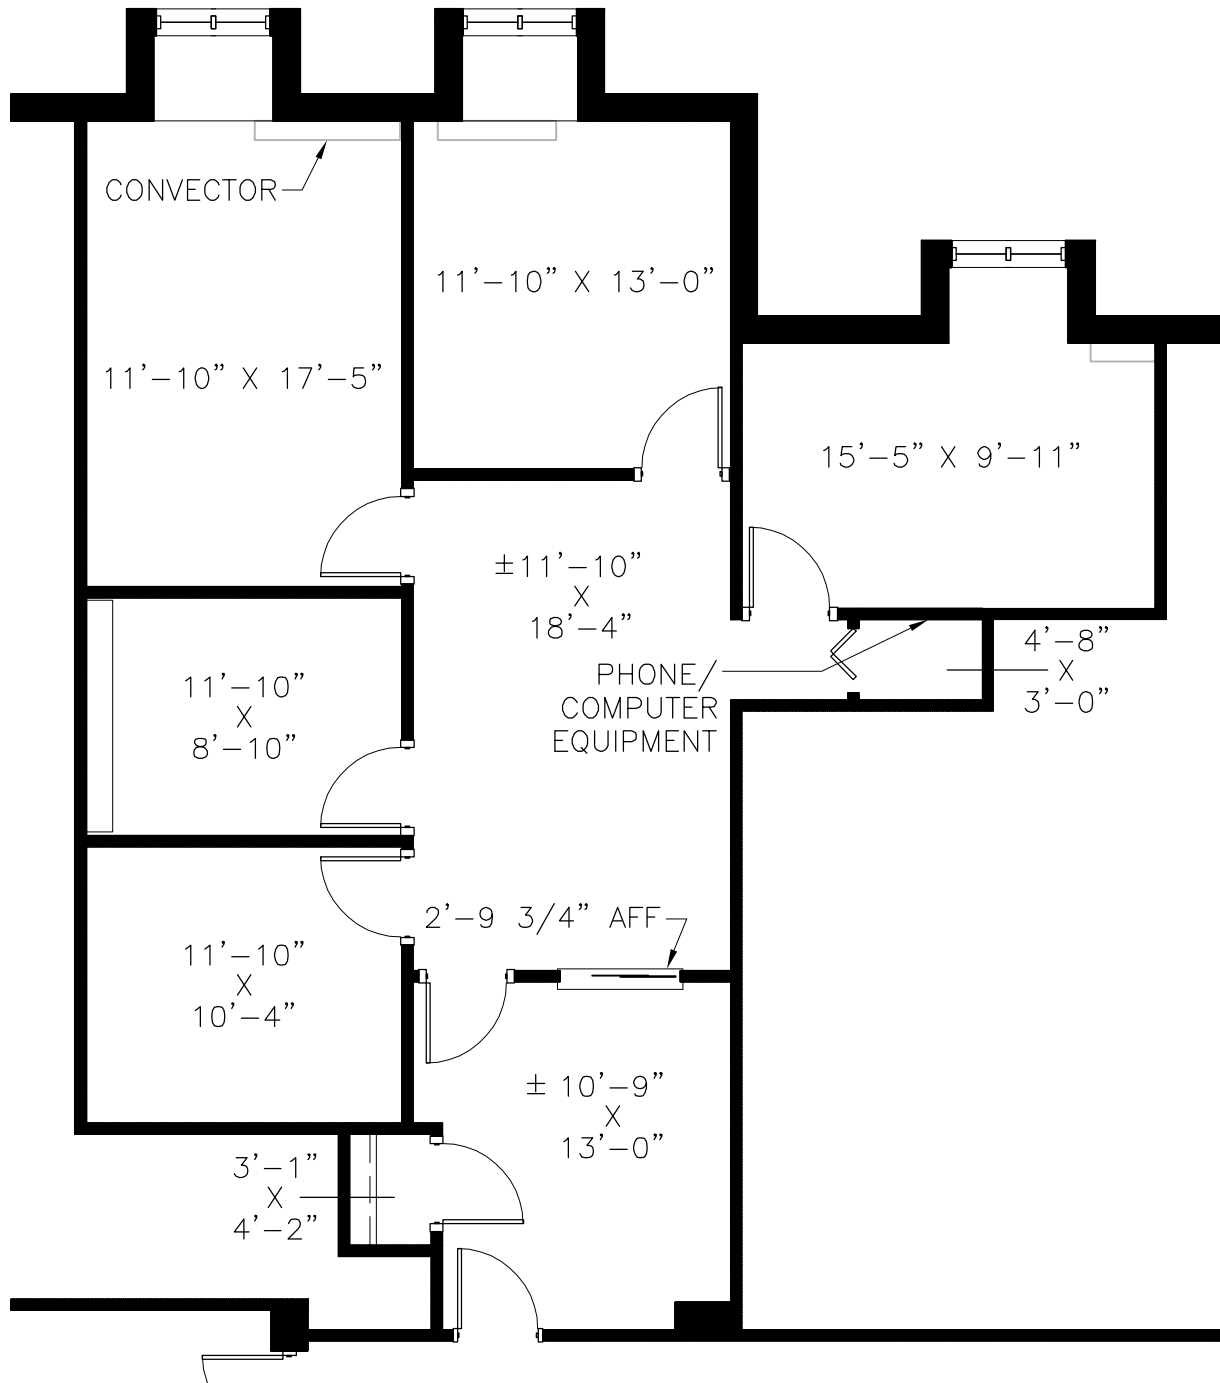

Suite 423 - As-Built Conditions

1,419 Rentable Square Feet

Scale:

N.T.S.