


188 Industrial Drive

188 Industrial Drive
Elmhurst, Illinois 60126

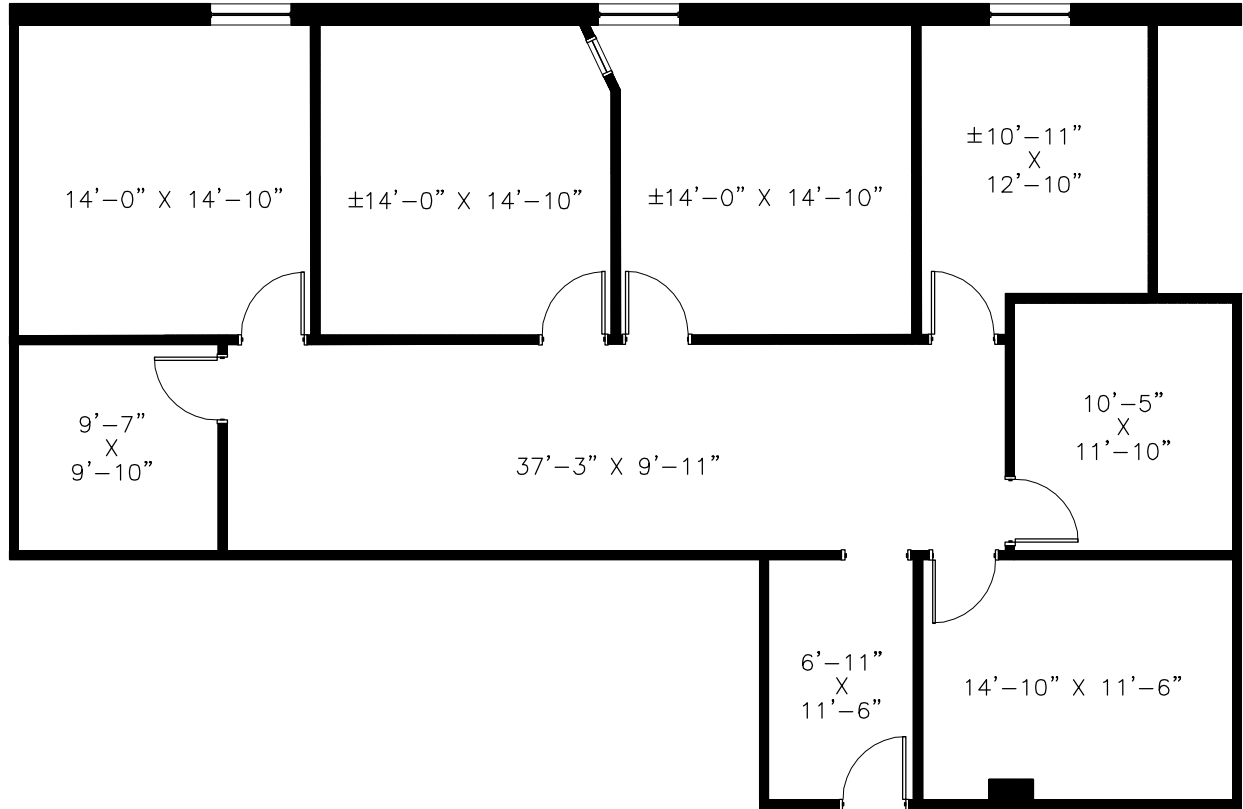

Suite #116 - As-Built Conditions

1,924 Rentable Square Feet

Scale:

N.T.S.