


# 188 Industrial Drive

188 Industrial Drive  
Elmhurst, Illinois 60126

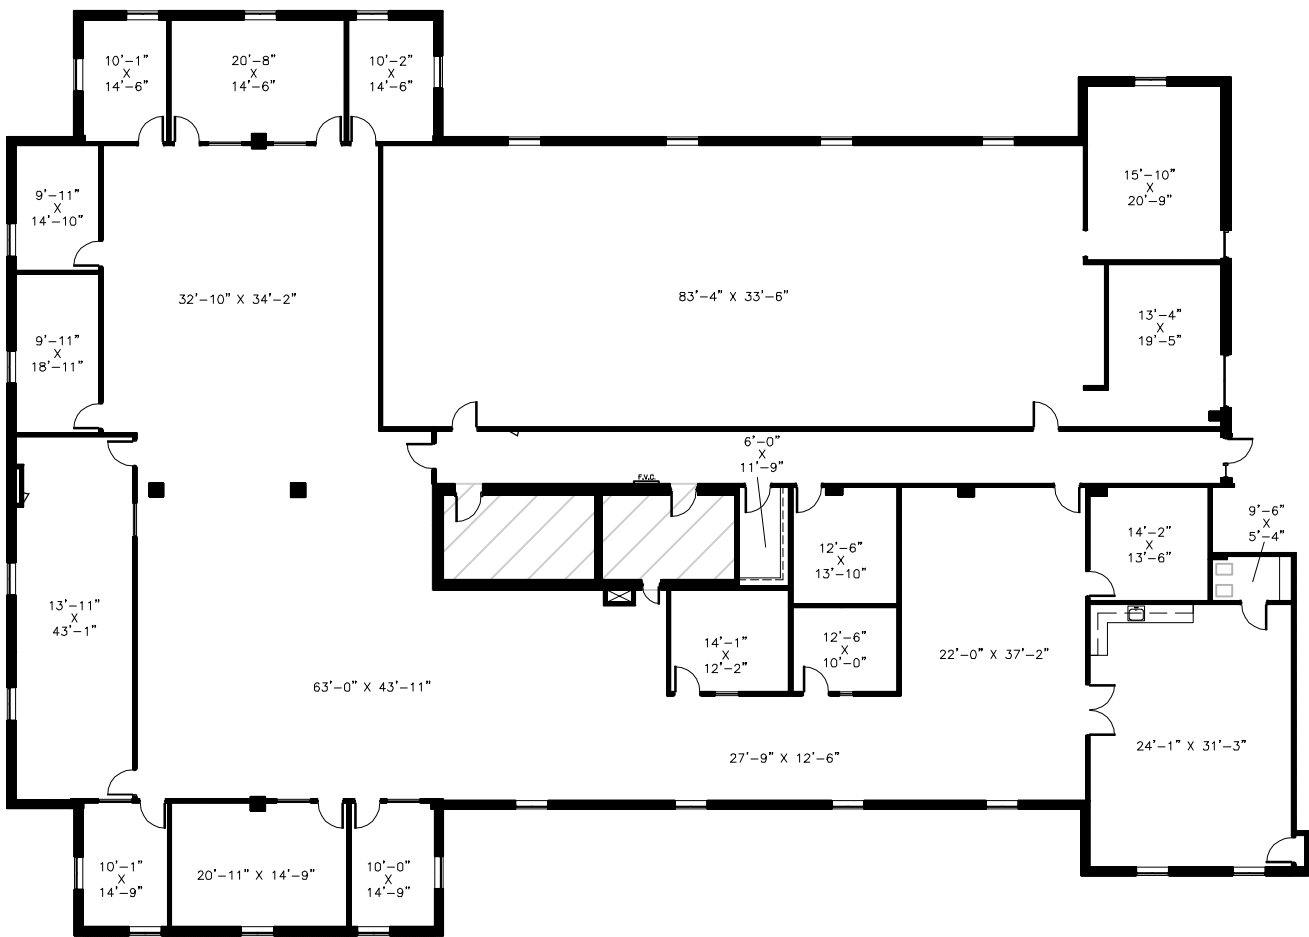

## Suite #320 - As-Built Conditions

14,312 Rentable Square Feet

Scale:

N.T.S.