


201 East Ogden Avenue

201 East Ogden Avenue
Hinsdale, IL, 60521

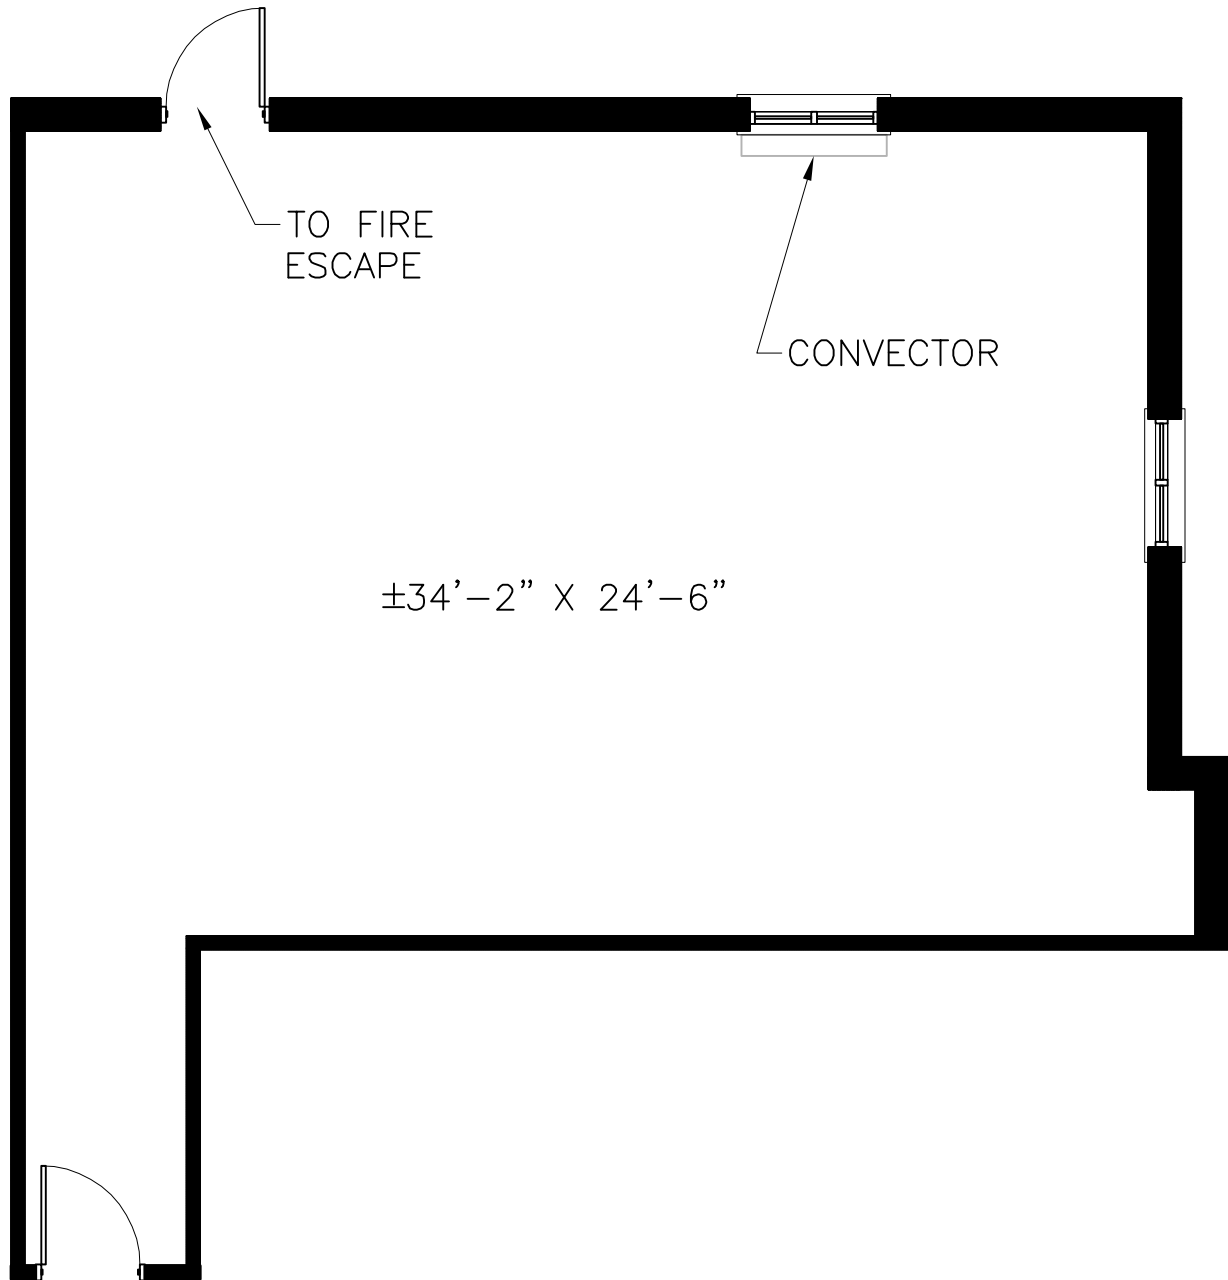

Suite 218 - As-Built Conditions

1,037 Rentable Square Feet

Scale:

N.T.S.