


900 Jorie Boulevard

900 Jorie Boulevard
Oak Brook, Illinois 60523

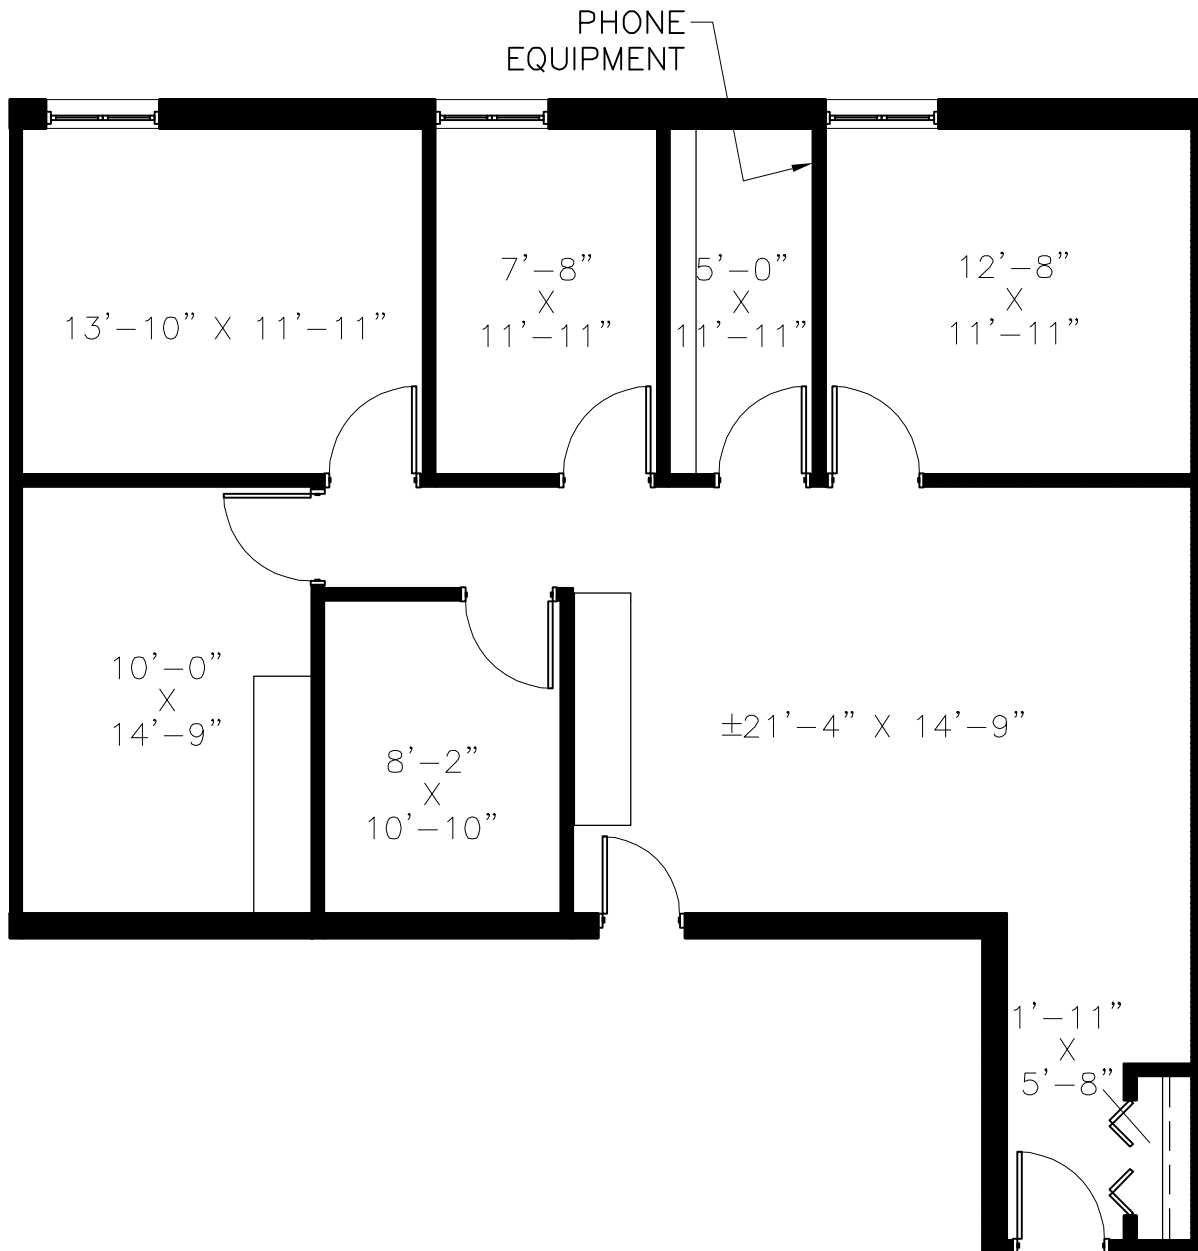

Suite #32 - As-Built Conditions

1,344 Rentable Square Feet

Scale:

N.T.S.