


930 York Road

930 York Road
Hinsdale, IL, 60521

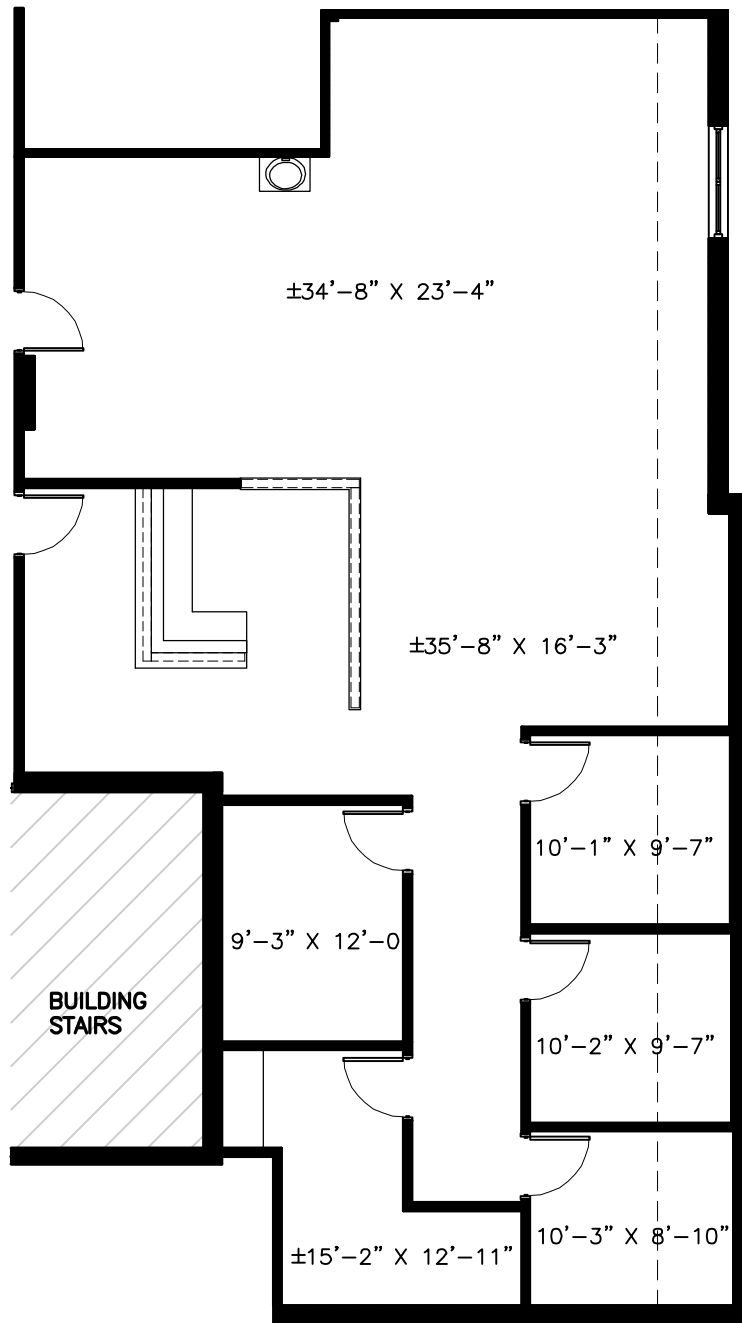

Suite #50 - As-Built Conditions

2,175 Rentable Square Feet

Scale:

N.T.S.