
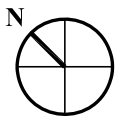


201 East Ogden Avenue

201 East Ogden Avenue
Hinsdale, IL 60521

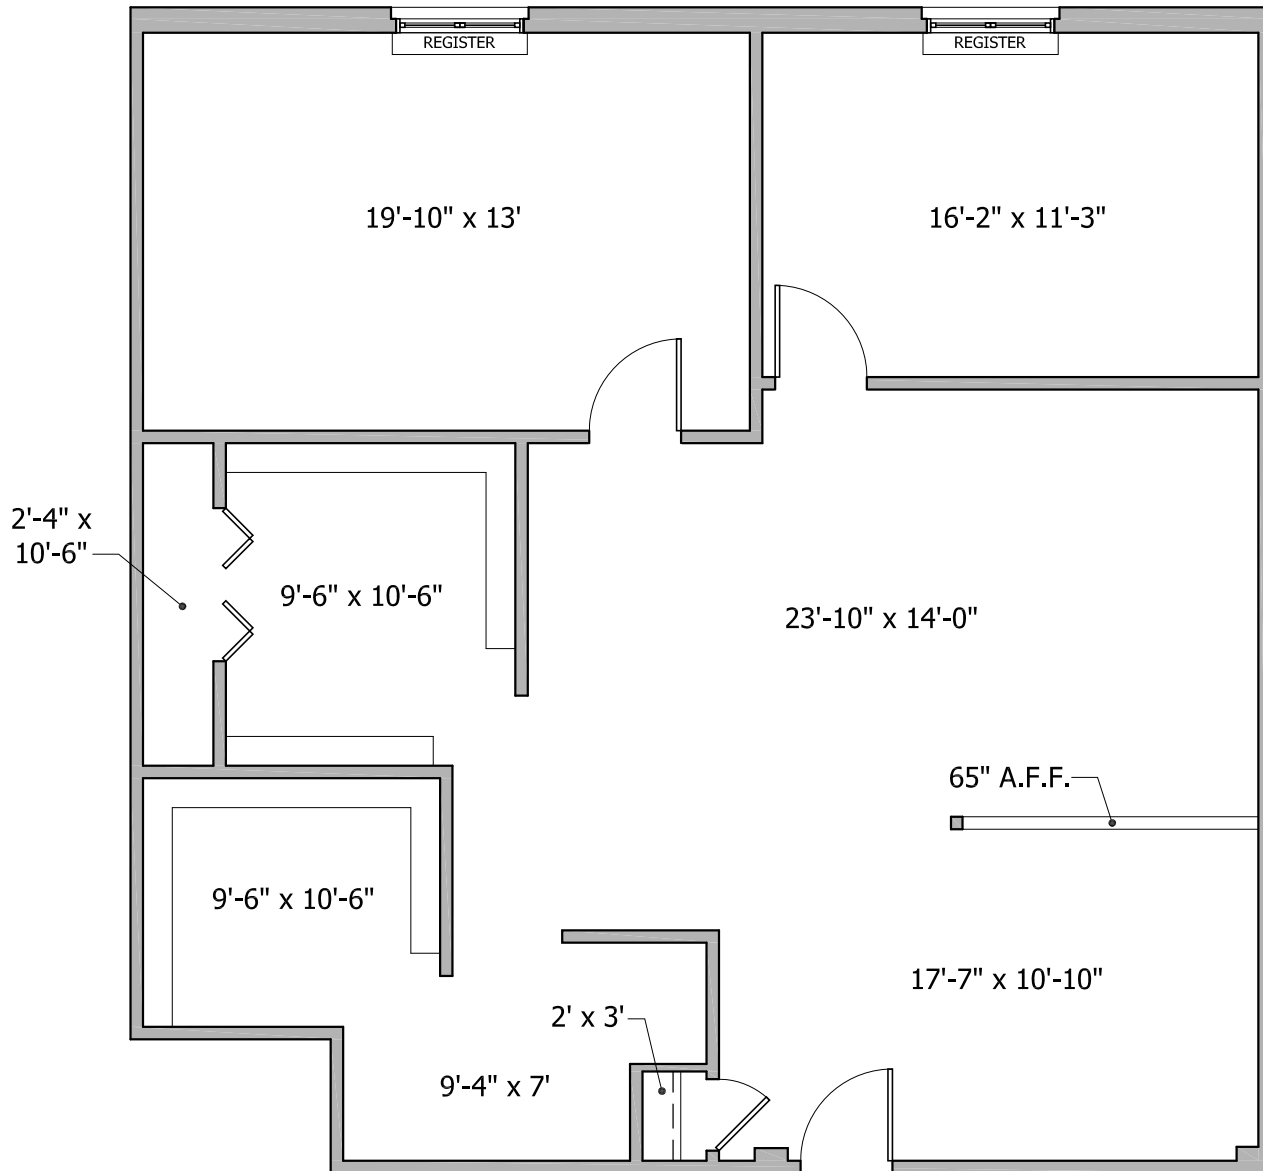

Suite 114 - As-Built Condition

1,517 Rentable Square Feet

Scale: N.T.S.